


Section 11 Township 10 Range 21W

Well No. ³~~#2~~ Miller

Company Jones, Shelborne & Farmer

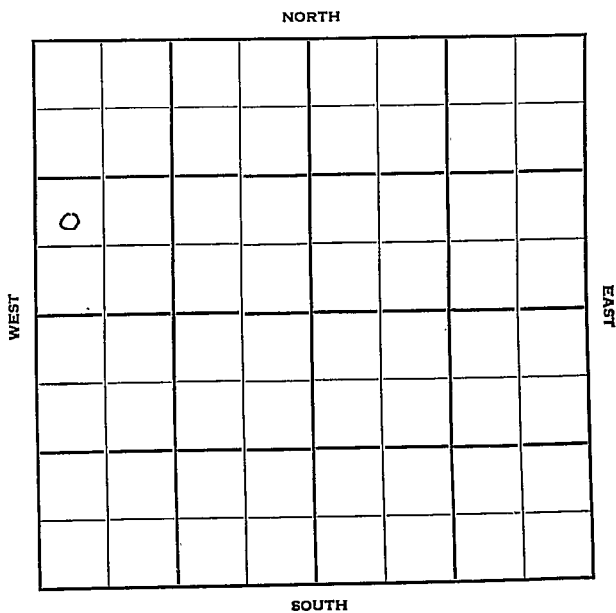

Graham

KANSAS 21W

Sec. 11 Twp. 10 R. 21W

Well No. 3 ~~#2~~ Miller Farm

Jones, Shelborne & Farmer Company

Contractor


_____ Ft. from N. Line

990' _____ Ft. from S. Line

_____ Ft. from E. Line

330' _____ Ft. from W. Line

NW SW NW

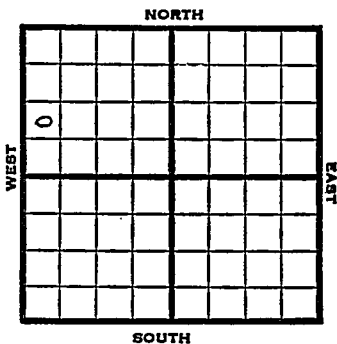

1951 Elev. 2289' REPORT

8/22 Cellar & Pits

9/26 Spud 8-28-51

Oil Well TD 3835'

8" @ 145'

Anhy 1760' Heeb. 3485' Lans. 3525'

Cong. 3798' Arb. 3827'

TD 3835'

5" @ 3831' S/ 12½ boph 1000 A

Comp. 3000 bopd

COMPLETED

County Graham State Kansas

Sec. 11 (Blk. 10 (Sur. 21W (Twp. Map No.)

Operator Jones, Shelborne & Farmer

Well No. 2 Farm Miller

Elev. _____ Location NW SW NW

0							

FIRST REPORT

990 Ft. From S Line NW

330 Ft. From W Line Quarter

Ist. Report AUG 22 1951

Completion _____

Remarks _____

Spudding Date _____

Drlg. Data _____

Cellar & pits

Kansas

Map No. _____ Sec. 11 Twp. 10 R. 21WWell No. 3 Miller2 203 Jones, Shelborne & Farmer Company

CORRECTION

Contractor

NW SW NW

SECTION PLAT

_____ Ft. from N. Line

990 Ft. from S. Line

_____ Ft. from E. Line

330 Ft. from W. Line

o			

Graham County

Location _____

Rig up _____

Drilling and Remarks:

Reported

#2 Miller

RECORD

Cased _____ in., _____ ft.

Sand _____

Gas _____

Oil _____

Total Depth _____

PRODUCTION

1st 24 hrs. Nat. _____

1st 24 hrs. after shot _____

Gas _____ Cu. Ft.

Dry Hole _____

Abandoned _____

Date

SEP 5 1951

19

J. E. TYRA

Scout

