

Section 11 Township 10 Range 21W

Well No. #2 DeYoung

Company Jones, Shelburne & Farmer

NORTH

						0	

WEST

EAST

SOUTH

Graham KANSAS

SEC.	TWP.	R.
11	10	21W ✓

WELL NO. 2 DeYoung FARM

COMPANY Jones, Shelburne & Farmer

CONTRACTOR J-S-F


Cooper Pool

330 Ft. from N. Line

Ft. from S. Line

990 Ft. from E. Line

Ft. from W. Line

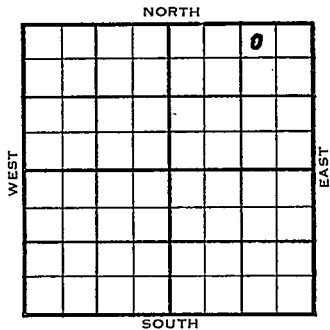

NW NE NE

1954	ELEVATION	REPORT
	2269'	

- 4/27 Cellar & Pits
- 5/5 8" @ 160 w/100  
Drlg. 2435'
- 6/23 Spud 5-1-54 - Oil Well  
TD 3837'  
8" @ 160'  
Heeb 3492', Tor 3516', Lans 3530',  
B KC 3755', Arb. 3834'  
TD 3837'  
5" @ 3834'  
CO to 3837'  
S/4 boph 500A  
S/50 boph  
Comp. 160 bopd

COMPLETED

County Graham State Kansas

Sec. 11 (Blk.) 10 (Sur.) 21W Map No. (Twp.)

Operator Jones, Shelburne & Farmer

Well No. 2 Farm DeYoung

Elev. \_\_\_\_\_ Location NW NE NE


330 Ft. From N Line NE

990 Ft. From E Line Quarter

Ist. Report APR 27 1954

Completion \_\_\_\_\_

Remarks \_\_\_\_\_

J.S.F. - Contr.

Spudding Date \_\_\_\_\_

Drlg. Data Cooper Pool

Cellar & pits

