


Graham

KANSAS

SECTION 11 TOWNSHIP 10 RANGE 21 WWELL NO. #3 DeYoung "C"COMPANY Jones, Shelburne & Farmer

NORTH

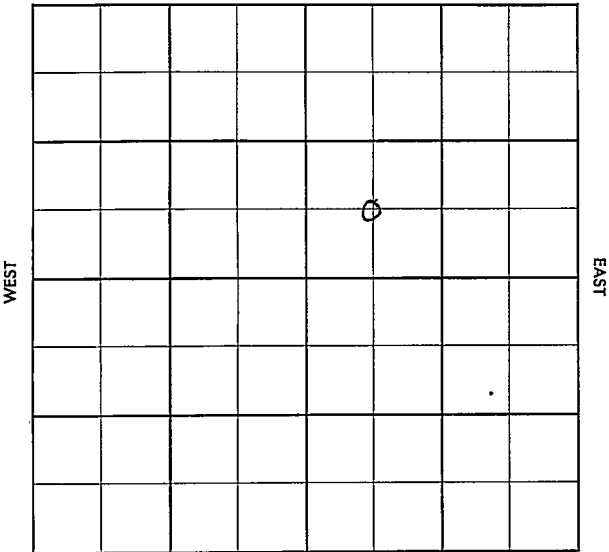

SOUTH

Graham

KANSAS

SEC.	TWP.	R.
11	10	21W

WELL NO.

#3 DeYoung "C"

FARM

COMPANY

Jones, Shelburne & Farmer

CONTRACTOR

Co. tools

Cooper


Ft. from N. Line

Ft. from S. Line

Ft. from E. Line

Ft. from W. Line

C SW NE

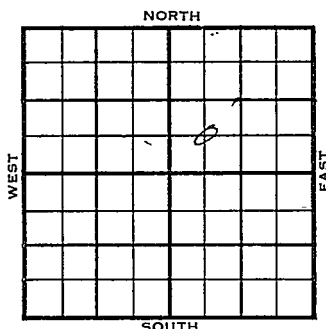

1956

ELEVATION

2253'

REPORT

1-25

Comm. ~~####~~ 1-24-56

2-8

Drlg. 3610

8 5/8" @ 168/125

DST 3820-23 1 hr. rec. 960' OCMSW

FP 160-460, BHP 760/20

No log.

Anh. 1750

H. 3475

Tb. 3502

L. 3515

BKC 3740

C. 3788

S. 3813

A. 3819

TD 3823'

ABANDONED

County Graham Elev. _____
 Sec. 11 Twp. 10 Rge. 21W
 Company Jones, Shilburne & Farmer
 FarmName DeYoung "C" No. 3

TOPS	DEPTH	LOG	DATUM	Loc. in Sec.
Anb.				C SW NE
Tr.				
H.				
Tr.				
Dg.				
Bl.				
L.				Geol. _____
K.C.				Contr. _____
B.K.C.				Co. tools _____
Ce.				
C.				Pool _____
M.				Cooper _____
M.				
K.				
Mz.				
Mq.				
V.				
S.				
S.				
A.				
R.				
Pe.				
G.				
T.D.				

Date Comm. 1-24-56

FIRST REPORT

JAN 25 '56

