


Section 11 Township 10 Range 21WWell No. #5 MillerCompany Jones, Shelburne & Farmer

NORTH

WEST

EAST

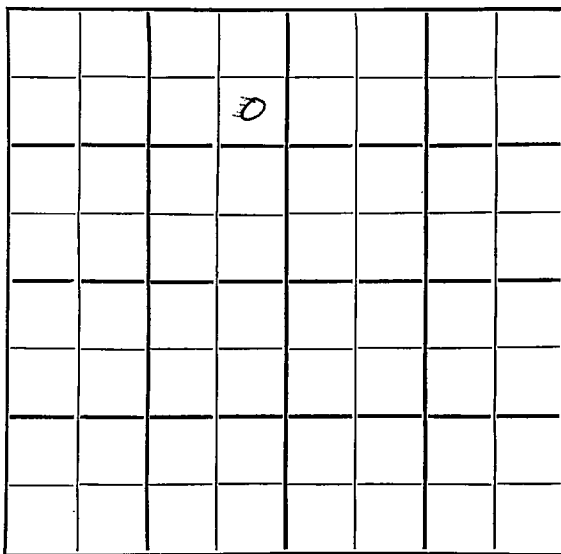

SOUTH

Graham KANSAS ✓

11

10

21W

Sec. _____ Twp. _____ R. _____

#5 Miller

Well No. _____ Farm _____

Jones, Shelburne & Farmer

Company _____

J-S-F

Cooper Pool

Contractor _____

990

Ft. from N. Line

Ft. from S. Line


330

Ft. from E. Line

Ft. from W. Line

SE NE NW

CSO-DHM

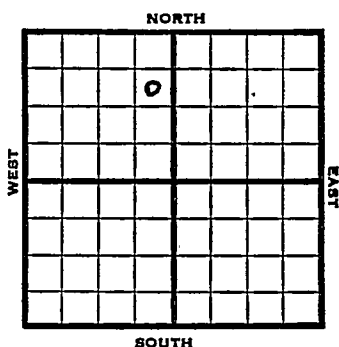

1953

Elev. 2245'

REPORT

3/25

Spud 3-23-53

4/2

8" @ 150 Heeb 3468'

Drlg. 3715'

4/9

Tor 3491, Lans 3506, Cong 3782, Arb 3861, Granite 4219

TD 4226 for SWD

4/16

5" @ 3965'

4/23

NR

4/29

Spud 3-23-53

SWD Well

TD 4226

8" @ 150

Heeb 3468, Tor 3491, Lans 3506, Cong 3782, Arb. 3861, Granite 4219

TD 4226

5" @ 3965


CO to 4226, 5000A

Comp. for SWD Well

ABANDONED

J. G. McGEHEE

County Graham State Kansas
 Sec. 11 (Blk.) 10 (Sur.) 21W Map No. (Twp.) (Rge.)
 Operator Jones, Shelburne & Farmer
 Well No. 5 Farm Miller
 Elev. 2245 Location SE NE NW

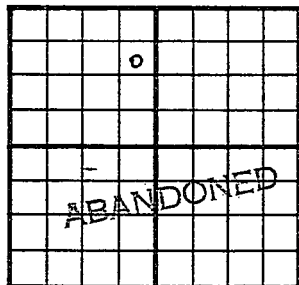

990 Ft. From N Line NW
330 Ft. From E Line Quarter
 Ist. Report
 Completion APR 29 1953
 Remarks Cooper Pool
J-S-F - Contr.
 Spudding Date 3-23-53

Drlg. Data SWD well TD 4226
8" @ 150 Heeb. 3468 Tor. 3491
Lans. 3506 Cong. 3782 Arb. 3861
Granite 4219 TD 4226 5" @ 3965
CO to 4226 5000 A
Comp. for SWD well