


Section 11 Township 10 Range 21W
Well No. 8 Miller
Company Jones, Shelburne & Farmer

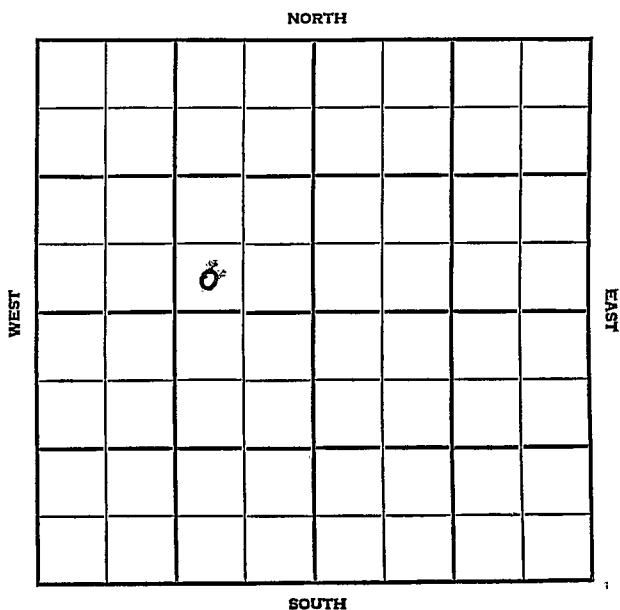

Graham

KANSAS

SEC.	TWP.	R.
11	10	21 W
WELL NO.		
# 8 Miller		
COMPANY		FARM
Jones, Shelburne & Farmer		
CONTRACTOR		

Cooper Pool


Ft. from N. Line

330 Ft. from S. Line

990 Ft. from E. Line

Ft. from W. Line

SW SE NW

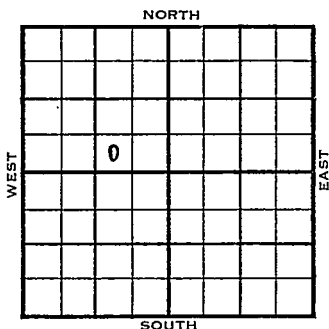

	ELEVATION	REPORT
1954	2263'	
10/20	Spud 10-13-54 8" @ 140' Heeb 3473 Brlg. 3640'	
12/15	Spud 10-13-54 Oil Well TD 3818' 8" @ 140' Heeb 3473', Tor. 3500' Lans 3519' B KC 3799', Arb. 3812' TD 3814' 5" @ 3813' DD 3818' S/ 10 boph Comp 166 bopd.	

COMPLETED

County Graham State KansasSec. 11 (Blk. Twp.) 10 (Sur. Rge.) 21W Map No.Operator Jones, Shelburne & FarmerWell No. 8 Farm MillerElev. 2263 Location SW SE NW

330 Ft. From S Line NW

990 Ft. From E Line Quarter

1st. Report

Completion DEC 15 1954Remarks Cooper PoolSpudding Date 10-13-54Drlg. Data Oil well TD 38188" @ 140 Heeb. 3473 Tor. 3500Lans. 3519 B KC 3799 Arb. 3812TD 3814 5" @ 3813 DD 3818 S/ 10 bophComp. 166 bopd

FABEN GILSTR