


Section 12 Township 10 Range 26W

Well No. 1 Guster

Company Jones, Shelburne & Farmer

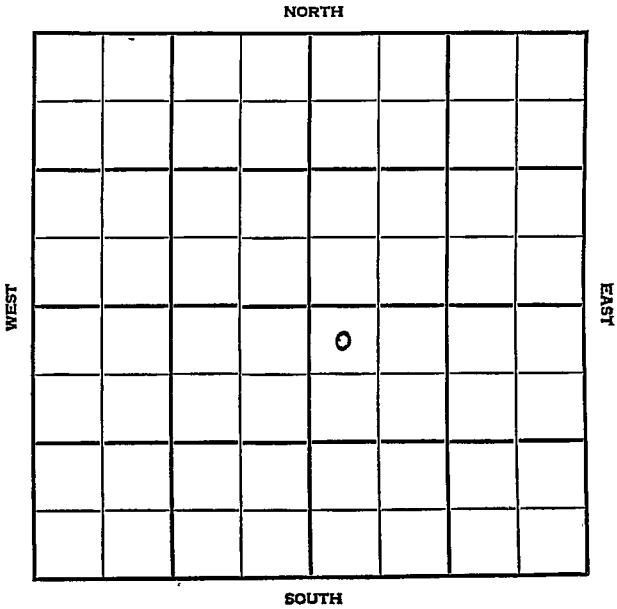

Sheridan

KANSAS


SEC.	TWP.	R.
12	10	26 W

WELL NO. # 1 Custer FARM

COMPANY Jones, Shelburne & Farmer

CONTRACTOR Co. tools

Wildcat
 330 Ft. from N. Line
 _____ Ft. from S. Line
 _____ Ft. from E. Line
 330 Ft. from W. Line

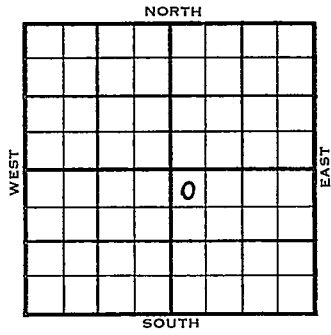

NW NW SE

1955	ELEVATION	REPORT
------	-----------	--------

3/9	Spud 3-6-55	
-----	-------------	--

