


Section 12 Township 10 Range 26W

Well No. #1 Mader

Company Jones, Shelburne & Farmer

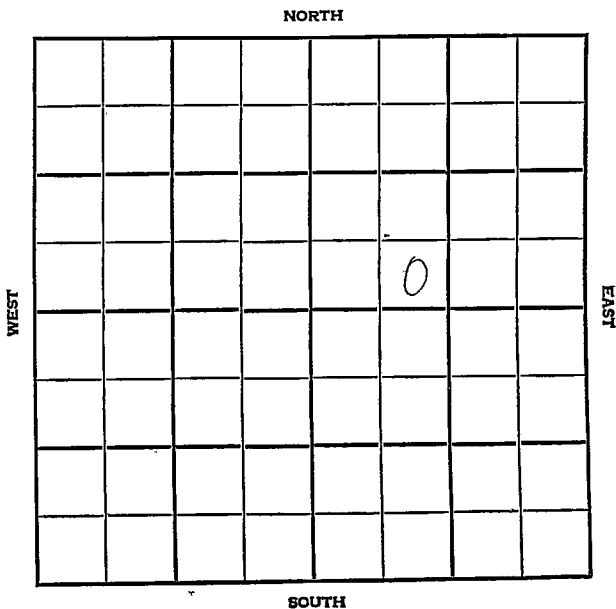

County Sheridan Elev. _____
 Sec. 12 Twp. 10 Rge. 26W
 Company Jones, Shelburne & Farmer
 Farm Name Mader No. 1

TOPS	DEPTH	LOG	DATUM	Loc. in Sec.
Anh.				SE SW NE
Tp.				
H.				
Tr.				
Dg.				
Bl.				
L.				Geol. _____
K.C.				Contr. _____
B.K.C.				Co. tools
Ce.				Pool
C.				
M.				
M.				
K.				
Mz.				
Mq.				
V.				
S.				
S.				
A				
R.				
Pe.				FIRST REPORT
G.				
T.D.				

NOV 7 1956
 0
 FIRST REPORT

Date Comm. 11-4-56

8" @ 160/150 WOC

[Handwritten signature]

NOV 10 1956

[Small handwritten mark]

Co.
 Sec.
 No.
 Sec.
 T.
 R.

County Sheridan Elev. 2581
 Sec. 12 Twp. 10 Rge. 26W
 Company Jones, Shelburne & Farmer
 FarmName Mader No. 1

TOPS	DEPTH	LOG	DATUM	Loc. in Sec.
Anh.	2205			SE SW NE
Ip.	3586			
H.	3804			
Tr.	3827			
Dg.				
Bl.				
L.	3846			Geol.
K.C.				Concr.
B.K.C.	4078			Co. tools
Ce.				Pool
C.				
M.				
M.				
K.				
Mz.				
Mo.				
V.				
S.				
S.				
A.				
R.				
Pe.				
G.				
TR.	4090			ABANDONED

NOV 23 '56
 o
 ABANDONED

Date Comm. 11-4-56
8" @ 160/150 WOC NOV 13 '56 3950 NO. 21 '56

D & a.

Co.

Sec.

No.

Sec.

T.

R.