

Rooks

KANSAS

Section 12 Township 10 Range 16WWell No. #1 CampCompany Cities Service

Wildcat

NORTH

6							

WEST

EAST

SOUTH

4

Sec. 12 **KANSAS** Twp. 10 R. 16W Rooks

Well No. #1 Camp Farm

Cities Service

Company

Wildcat

NORTH


330' Ft. from N. Line

Ft. from S. Line

Ft. from E. Line

330' Ft. from W. Line

NW/C

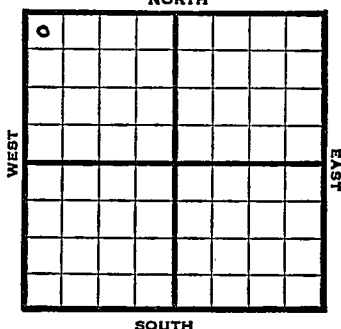

1948

Elev 1938'

REPORT

2/11 Drlg. 1520'

2/18 8" @ 229'
Drlg 2470'

2/25 Drlg. 3310'

3/3 Dodge 3061'
Lansing 3084'
TD 3343'
4 1/2" @ 3343'
RUST

3/10 "

3/17 26 shots 3188-95'
36 shots 3138-50'
30 shots 3119-27'
29 shots 3083-95'
31 shots 3061-69'

3/24 5000 Acid
Pump 15 bbls oil & 17 W in 24 hrs.

3/31 16 shots 3331-35'
24 " 3298-3304'
24 " 3274-80
24 " 3228-34 - 4000 acid
Pump 12 bbls. oil & 35 W in 3 hrs.
Pump 13 bbls. oil & 26 W in 24 hrs.

4/7

4/14

4/21

4/28

5/5

5/12

"
"
"
"
"

OVER

1948

5/19 Pump 13 bbls oil / 26 W in 24 hrs.

5/26 "

6/1 "

6/9 "

6/16 TD 3343'

Lansing 3084'

4 $\frac{1}{2}$ " @ 3343

Perf 5000 acid

Pump 6 $\frac{1}{2}$ Oil / 20W Pot

26° Gr.

Comp.

COMPLETED

Map No. _____ Sec. 12 Twp. 10 R. 16W

Well No. 1 Camp _____

_____ Cities Service _____ Company

_____ FIRST REPORT _____ Contractor

NW/C

SECTION PLAT

330 Ft. from N. Line

_____ Ft. from S. Line

_____ Ft. from E. Line

330 Ft. from W. Line

0			

Rooks County

Location _____

Rig up _____

Drilling and Remarks:

drlg. 1520.

RECORD

Cased _____ in., _____ ft.

Sand _____

Gas _____

Oil _____

Total Depth _____

PRODUCTION

1st 24 hrs. Nat. _____

1st 24 hrs. after shot _____

Gas _____ Cu. Ft.

Dry Hole _____

Abandoned _____

Date

FEB 1 1 1948 19

S. J. LEWIS Scout

Map No. 64 Sec. 12 Twp. 10 R. 16W

Well No. 1 Camp

Cities Service

Company

COMPLETE

Contractor

NW/C

E. 11/938
SECTION PLAT

0			

330 Ft. from N. Line

 Ft. from S. Line

 Ft. from E. Line

330 Ft. from W. Line

Rooks County

Location

Rig up

Drilling and Remarks:

Lions 3084

4 1/2" @ 343

Prof.

5000 acid

Pump 6 1/2 oil +

20W P.T.

26° Br

RECORD

Cased in., ft.

Sand

Gas

Oil

Total Depth 3343

PRODUCTION

1st 24 hrs. Nat.

1st 24 hrs. after shot

Gas Cu. Ft.

Dry Hole

Abandoned

Date

JUN 16 1948

19

S. J. LEWIS

Scout,