

Section 12 Township 10 Range 18WWell No. #1 RossCompany B & R Drilg.

0								

NORTH

WEST

EAST

SOUTH

4

Rooks

KANSAS

Sec. 12 Twp. 10 R. 18W

Well No. #1 Ross Farm

Harry Gore Company

B & R Drlg. Contractor


Wildcat
330' Ft. from N. Line

 Ft. from S. Line

 Ft. from E. Line

330' Ft. from W. Line

NW NW NW

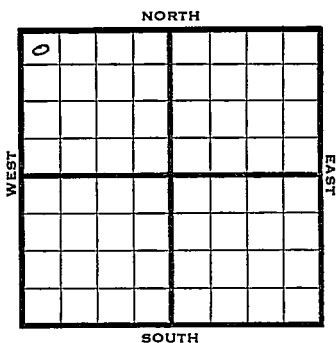

1950

Elev 2145

REPORT

4/19

RUR

5/17

TD 3796
8" @ 200
Lans 3382
Arb 3761-96 TD
D&A

ABANDONED

Map No. _____ Sec. 12 Twp. 10 R. 18WWell No. 1 Ross

_____ Harry Gore _____ Company

_____ B & R Drlg. _____ Contractor

NW NW NW

SECTION PLAT

330 Ft. from N. Line

_____ Ft. from S. Line

_____ Ft. from E. Line

330 Ft. from W. LineRooks County

Location _____

Rig up _____

Drilling and Remarks: _____

R U R

RECORD

Cased _____ in., _____ ft.

Sand _____

Gas _____

Oil _____

Total Depth _____

PRODUCTION

1st 24 hrs. Nat. _____

1st 24 hrs. after shot _____

Gas _____ Cu. Ft.

Dry Hole _____

Abandoned _____

Date

APR 19 1950 19 J. E. TYRA Scout

Map No. _____ Sec. 12 Twp. 10 R. 18WWell No. 1 RossHarry Gore

Company

Contractor

NW NW NW


E1. 2145

SECTION PLAT

330 Ft. from N. Line

_____ Ft. from S. Line

_____ Ft. from E. Line

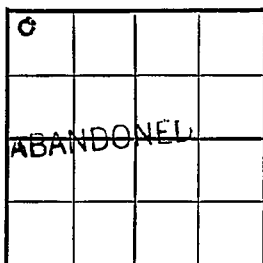330 Ft. from W. Line

Rocks

Location _____

Rig up _____

Drilling and Remarks:

8" @ 200Leas 3382anb 3761-96TDD + A

RECORD

Cased _____ in., _____ ft.

Sand _____

Gas _____

Oil _____

Total Depth 3796

PRODUCTION

1st 24 hrs. Nat. _____

1st 24 hrs. after shot _____

Gas _____ Cu. Ft.

Dry Hole _____

Abandoned _____

Date

MAY 17 1950

19

J. E. TYRA

Scout