

Section 12 Township 10 Range 19W

Well No. #1 Gick

Company C.U. Bay Pet.

NORTH

WEST							EAST
	0						

SOUTH

Rooks

KANSAS


SEC.	12	TWP.	10	R.	19W ✓
------	----	------	----	----	-------

WELL NO. #1 Gick FARM

COMPANY C.U. Bay Pet.

CONTRACTOR Lewis Drlg.
John Pool

990 Ft. from N. Line
 _____ Ft. from S. Line
 _____ Ft. from E. Line
 330 Ft. from W. Line

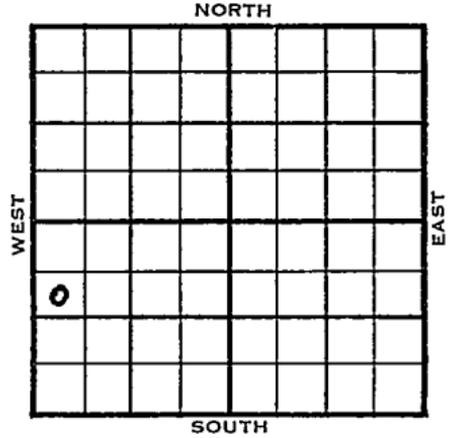

SW NW SW

	ELEVATION	REPORT
1954	2120'	

3/2 Spud 2-23-54
 8" @ 156'
 Anhy 1490', Top 3063', Heeb 3279'
 Drlg 3285'

3/10 Spud 2-23-54 D & A TD 3645
 8" @ 156 Anhy 1490 Top 3063
 Heeb 3279
 DST 3286-3312 open 1 hr rec 10' mud
 Lans. 3319
 DST 3343-88 open 1 hr rec 25' SOCM
 0#
 DST 3386-3410 open 1 hr rec 35' OCM
 180#
 DST 3464-3506 open 1 1/4 hr rec 25' mud
 280#
 Cong. 3553 Arb. 3640'
 DST 3640-45, open 1 hr rec 12' mud
 240# TD 3645'
 D & A

ABANDONED

County _____ Rooks _____ State **Kansas**

Sec. 12 (Blk. Twp.) 10 (Sur. Rge.) 19W Map No. _____

Operator **C. U. Bay Pet.**

Well No. 1 Farm **Gick**

Elev. 2120 Location **SW NW SW**

990 Ft. From N Line SW

330 Ft. From W Line Quarter

1st. Report _____

Completion **MAR 10 1954**

Remarks **Vohn Pool**

Lewis Drlg. - Contr.

Spudding Date **2-23-54**

Drlg. Data **D & A TD 3645**

8" @ 156 Anhy 1490 Top. 3063

Heeb. 3279 DST 3286-3312 open 1 hr.

Rec. 10' mud Lans. 3319 DST. 3343-88

open 1 hr. Rec. 25' socm 0#

DST 3386-3410 open 1 hr. Rec. 35' ocm

180# DST 3464-3506 open 1 1/4 hr. Rec.

25' mud 280# Cong. 3553 Arb. 3640

DST 3640-45 open 1 hr. Rec. 12' mud

240# TD 3645

D & A