

Rooks

KANSAS

SECTION 12 TOWNSHIP 10 RANGE 20W

WELL NO. #7 Desbien

COMPANY Continental

NORTH

	0						

WEST

EAST

SOUTH

Rooks

KANSAS

SEC. 12	TWP. 10	R. 20W
------------	------------	-----------

WELL NO.

#7 Desbien

FARM

COMPANY

Continental

CONTRACTOR

Garvey

Marcotte


Ft. from N. Line

Ft. from S. Line

Ft. from E. Line

Ft. from W. Line

SE NW NW

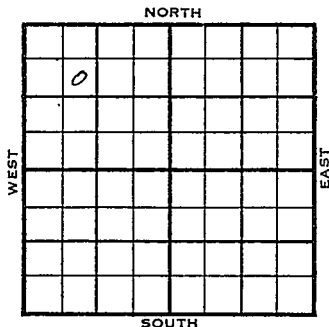

1956

ELEVATION

2225'

REPORT

5-16

MIR

5-29

Comm. 5-15-56

8 5/8" @ 246 w/175

DST 3623-60 op 1 hr. rec. 10' mud,
BHP 0#.DST 3738-66 op 30 min, rec. 65' mud,
(oil spkd), BHP 0#.

D & A

Anh. 1664', H. 3443', L. 3481', A. 3818'

Log tops: H. 3442', Tr. 3460', BKG 3699'

A. 3818'.

TD 3856'

ABANDONED

County Rooks Elev. _____
 Sec. 19 Twp. (19) Rge. 20W
 Company Continental
 Farm Name Desbien No. 7

TOPS	DEPTH	LOG	DATUM	Loc. in Sec.
Anh.				SE NW NW
Tr.				
H.				
Tr.				
Dg.				
Bl.				
L.				
K.C.				Geol.
B.K.C.				Contr.
Ce.				<u>Farvey</u>
C.				<u>Pool Gick</u>
M.				<u>Marcotte</u>
M.				
K.				
Mz.				
Me.				
V.				
S.				
S.				
A.				
R.				
Pe.				
G.				
T.D.				

FIRST REPORT
 MAY 16 '50

Date Comm.

M I R

S S YAM

R. G.

County Rooks Elev. 2225
 Sec. 12 Twp. 12 Rge. 20W
 Company Continental
 FarmName Desbien No. 7

TOPS	DEPTH	LOG	DATUM	Loc. in Sec.
Anh.	1664			SE NW NW
TP.				
H.	3443	3442		
Tr.		3460		
Dg.				
BL.				
L.	3481	3480	1253	Geol.
K.C.		3697	1472	Dontr.
B.K.C.				Garvey
Ce.				Pool
C.				Mareotte
M.				
M.				
K.				
Mz.				
Mo.				
V.				
S.				
S.	3818	3818	1593	
A.				
R.				
PE.				
G.				
TD.	3856			

ABANDONED

Date Comm. MAY 29 1956
 M I R MAY 23 '56 5-15-56 85/8246

1175 ϕ 3528 MAY 29 '56 DST 3623-60
 1hr. rec 10' Md BHP 0 DST
 3738-66 30" rec 65' Md (oil
 spkd) DHP 0

D & A