


Section 12 Township 10 Range 20W

Well No. #1 Desbien

Company Continental

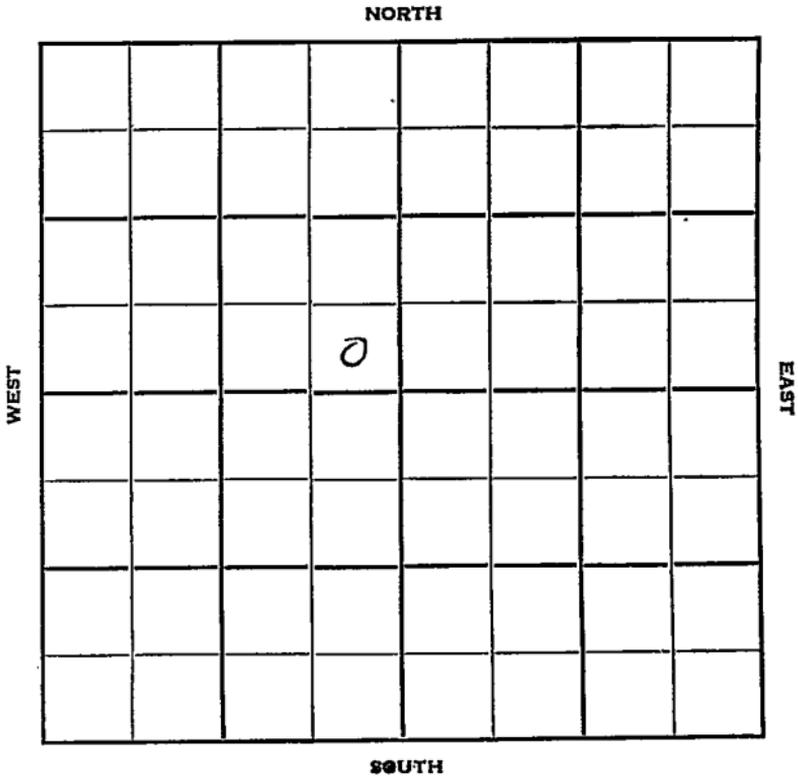

Rooks **KANSAS**  
10 20W ✓  
R.

Sec. 12 Twp. ---

Well No. #1 Desbien Farm

Continental Company

Darland Pool Contractor


         Ft. from N. Line

330' Ft. from S. Line

330' Ft. from E. Line

         Ft. from W. Line

SE SE NW

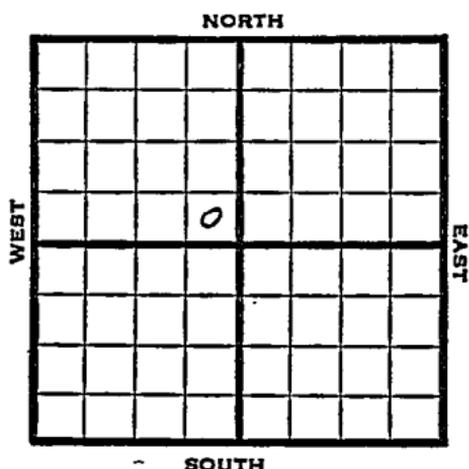

1950

Elev. 2203' REPORT

11/29

Spud 11-25-50  
10" @ 358'  
Anhy 1618'  
Drig. 1680'

12/5

Spud 11-25-50  
Oil Well TD 3741  
10" @ 358' Anhy 1618'  
Top 3214' Heeb. 3410  
Dodge 3427' Lans. 3448'  
BKC 3661' Cong. 3689  
Arb. 3738'  
TD 3741' 7" @ 3740  
FU 1600' oil 1½ hr S/20 boph  
Comp. 3000 bopd  
**COMPLETE**

County Rooks State Kansas

Sec. 12 (Blk. Twp.) 10 (Sur. Rge.) 20W Map No.

Operator Continental

Well No. 1 Farm Desbien

Elev. \_\_\_\_\_ Location SE SE NW



330 Ft. From S Line NW

330 Ft. From E Line Quarter

1st. Report NOV 29 1950

Completion \_\_\_\_\_

Remarks \_\_\_\_\_

Spudding Date 11-25-50

Drlg. Data Berland Pool

10" @ 358 Anhy 1618 drlg. 1680

J. E. TYRA


County \_\_\_\_\_ Rooks \_\_\_\_\_ State **Kansas**

Sec. **12** (Blk. Twp.) **10** (Sur. Rge.) **20W** Map No. \_\_\_\_\_

Operator **Continental**

Well No. **1** Farm **Desbien**

Elev. **2203** Location **SE SE NW**

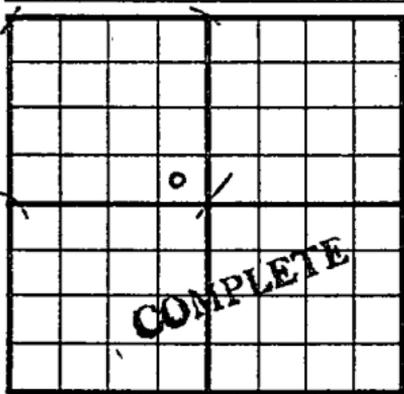

**330** Ft. From **S** Line **NW**  
**330** Ft. From **E** Line **Quarter**

1st. Report \_\_\_\_\_

Completion **FEB 7 1951**

Remarks **Berland Pool**

Spudding Date **11-25-50**

Drlg. Data **Oil well TD 3741**

**10" @ 358 Anhy 1618 Top. 3214**

**Heeb. 3410 Dodge 3427 Lans. 3448**

**B KC 3661 Cong. 3689 Arb. 3738**

**TD 3741 7" @ 3740 FU 1600' oil 1½ hr.**

**S/ 20 boph Comp. 3000 bopd**

**J. E. TYRA**