


Section 12 Township 10 Range 20-W

Well No. #2 Desbien

Company Sohio et al

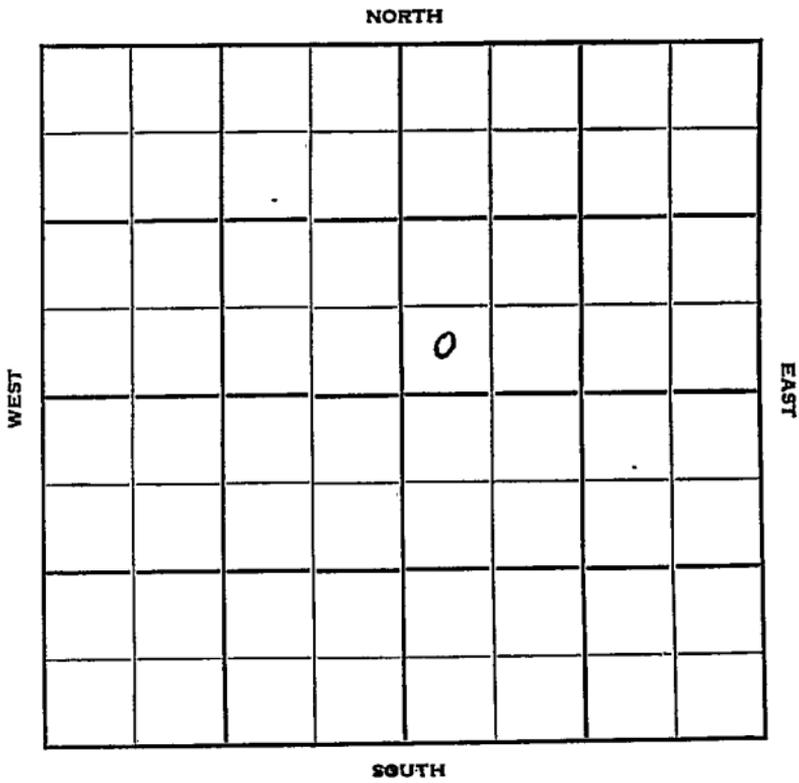

Rooks 10

KANSAS

Sec. 12

Twp.

10

R.

20W

Well No. #2 Desbien

Farm

Sohio et al

Company

Rine Drlg. - Contr.

Contractor

Berland Pool

Ft. from N. Line

330'


Ft. from S. Line

Ft. from E. Line

330'

Ft. from W. Line

SW SW NE

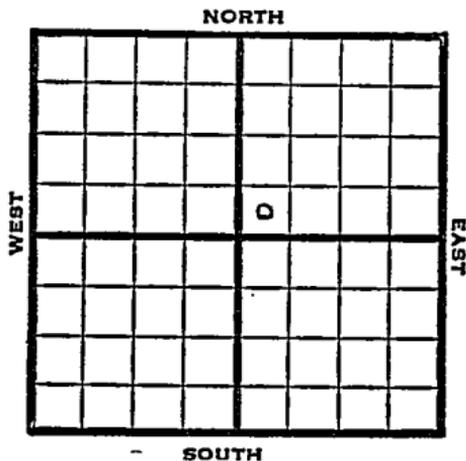

1950

Elev 2224'

REPORT

11/15 Spud 11-11-50  
Anhy 1624'  
8-5/8" @ 1634'

12/20 Anhy 1624  
8 5/8" @ 1634  
Top 3222 Heeb 3426  
Lans 3464  
DST 3441-65 opn 1 hr rec 85' mud  
& SW  
DST 3611-38 opn 1 hr rec 510' sli mud  
cut oil  
BHP 1040#  
DST 3654-77 opn 1 hr rec 210' hvy mud  
cut oil  
Arb 3755-60 TD  
5" @ 3756  
FU 2000' oil 3 1/2 hr  
S/20 boph  
DD 3761  
S/85 boph 8 hr  
Comp 3000 bopd  
Completed TD 3761'  
**COMPLETED**



