

Section 12 Township 10 Range 20WWell No. #3 DesbienCompany Sohio et al

NORTH

						0	

WEST

EAST

SOUTH

Rooks KANSAS

Sec. 12 Twp. 10 R. 20W ✓

Well No. #3 Desbien Farm

Sohio et al Company

Rine Drlg. - Contr. Contractor

Berland Pool


 Ft. from N. Line

330' Ft. from S. Line

990' Ft. from E. Line

 Ft. from W. Line

SW SE NE

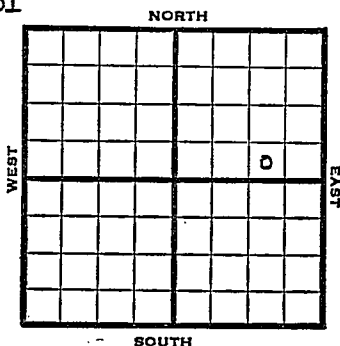

1950 Elev. 2235' REPORT

12/6 Spud 11-30-50
8-5/8" @ 308'
Drlg. 2625'

1951
1/3 Spud 11-30-50
Oil Well TD 3778'
8-5/8" @ 308
Top 3233' Heeb. 3440
Lans. 3478'
DST 3503-25 opn 1 hr Rec. 50' sw
& mud
DST 3622-50 opn 1/2 hr Rec. 840' gas
760' free oil DST 3665-92 opn 1 hr
Rec. 150' mud & geo
Arb. 3771-76 SO 5 1/2" @ 3774
DD 3778 S/10 boph 500 A
Comp. 2930 bopd

COMPLETED


Operator Sohio et al.

Well No. 3 Farm Desbien

Elev. 2235 Location SW SE NE

FIRST REPORT

330 Ft. From S Line NE

990 Ft. From E Line Quarter

1st. Report DEC 6 1950

Completion

Remarks

Rine Drlg. - Contr.


Spudding Date **11-30-50**

Drlg. Data Berland Pool

8 5/8" @ 308 drlg. 2625

J. E. TYRA

County _____ Rooks _____ State **Kansas**
 Sec. 12 (Blk. Twp.) 10 (Sur. Rge.) 20W Map No. _____
 Operator **Sohio etal.**
 Well No. 3 Farm **Desbien**
 Elev. 2235 Location **SW SE NE**

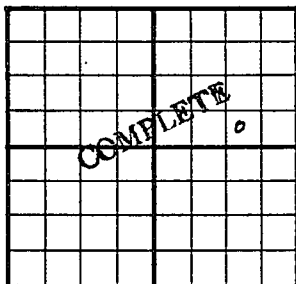

330 Ft. From S Line **NE**
 990 Ft. From E Line **Quarter**
 1st. Report _____
 Completion **JAN 3 1951**
 Remarks **Berland Pool**
Rine Drlg. - Contr.
 Spudding Date **11-30-50**

Drlg. Data **Oil well** **TD 3778**
8 5/8" C 308 Top. 3233 Heeb. 3440
Lans. 3478 DST 3503-25 open 1 hr.
Rec. 50' sw & mud DST 3622-50 open $\frac{1}{2}$ hr.
Rec. 840' gas 760' free oil DST 3665-92
open 1 hr. Rec. 150' mud & gco
Arb. 3771-76 SO 5 1/2" C 3774 DD 3778
S/ 10 boph 500 A Comp. 2930 bopd

J. E. TYRA