FORM 51 25M 8-50 WESTERN


Rooks

KANSAS

Section 12 Township 10 Range 20W

Well No. #4 Desbien

Company Sohio et al

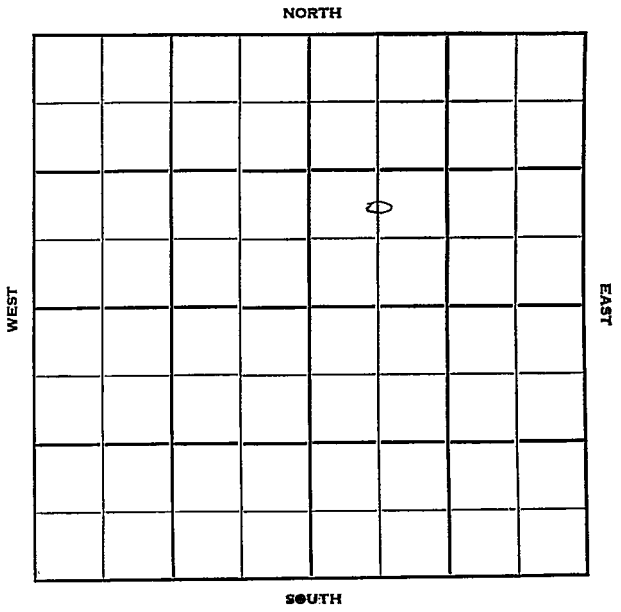

FORM 252-B
10M 11-50 PETROL

Rooks KANSAS

Sec. 12 Twp. 10 R. 20W

Well No. #4 Desbien Farm

Sohio et al Company

Rine Drlg. - Contr. Contractor

Berland Pool


____ Ft. from N. Line

990' Ft. from S. Line

____ Ft. from E. Line

660' Ft. from W. Line

C N L SW NE

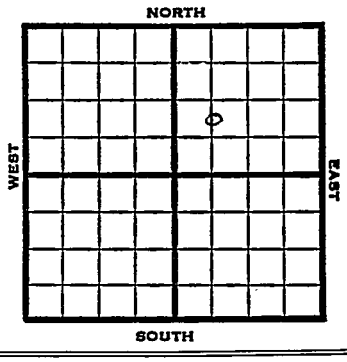

1950	Elev. 2226 REPORT
12/20	. Spud 12-14-50 8-5/8" @ 302' Drlg. 2900'
1951 1/31	Spud 12/14/50 Oil Well TD 3788 8-5/8" @302 Heeb. 3446 Lans. 3484 DST 3638-64 open 1 hr. Rec. 5' mud DST 3672-96 open 1 hr. Rec. 20' vhocm some free oil Arb. 3784-88 TD 5½" @3785 4 goph 500 A S/ 1-3/4 boph 1000 A S/ 20 boph Comp. Depth pot. 3029 bopd

COMPLETED

FORM 275 FOR SALE BY KANSAS BLUE PRINT CO.


County Rooks State Kansas

Sec. 12 (Blk. Twp.) 10 (Sur. Rge.) 20W Map No.

Operator Sohio etal.

Well No. 4 Farm Desbien

Elev. Location C N L SW NE

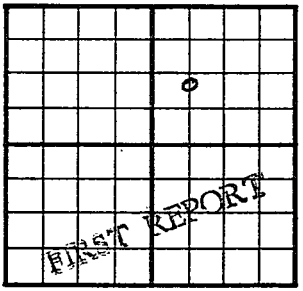

990 Ft. From S Line NE

660 Ft. From W Line Quarter

1st. Report DEC 2 0 1950

Completion

Remarks

Rine Drlg. - Contr.

Spudding Date 12-14-50

Drlg. Data Berland Pool

8 5/8" @ 302 drlg. 2900

J. E. TYRA

FORM 275 FOR SALE BY KANSAS BLUE PRINT CO.


County Rooks State Kansas

Sec. 12 (Blk. Twp.) 10 (Sur. Rge.) 20W Map No.

Operator Sohio etal.

Well No. 4 Farm Desbien

Elev. 2226 Location C N L SW NE

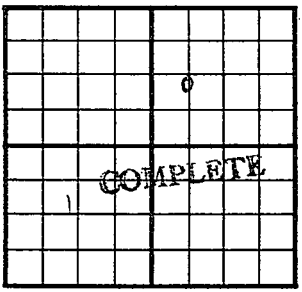

990 Ft. From S Line NE

660 Ft. From W Line Quarter

1st. Report

Completion JAN 31 1951

Remarks Berland Pool

Rine Drlg. - Contr.

Spudding Date 12-14-50

Drlg. Data Oil well TD 3788

8 5/8" @ 302 Heeb. 3446 Lans. 3484

DST 3638-64 open 1 hr. Rec. 5' mud

DST 3672-96 open 1 hr. Rec. 20' vhocm

some free oil Arb. 3784-88 TD 5½" @

3785 4 goph 500 A S/ 1 3/4 boph

1000 A S/ 20 boph

Comp. Depth pot. 3029 bopd

J. E. TYRA