


Section 12 Township 10 Range 20W

Well No. #4 Desbien

Company Continental Oil

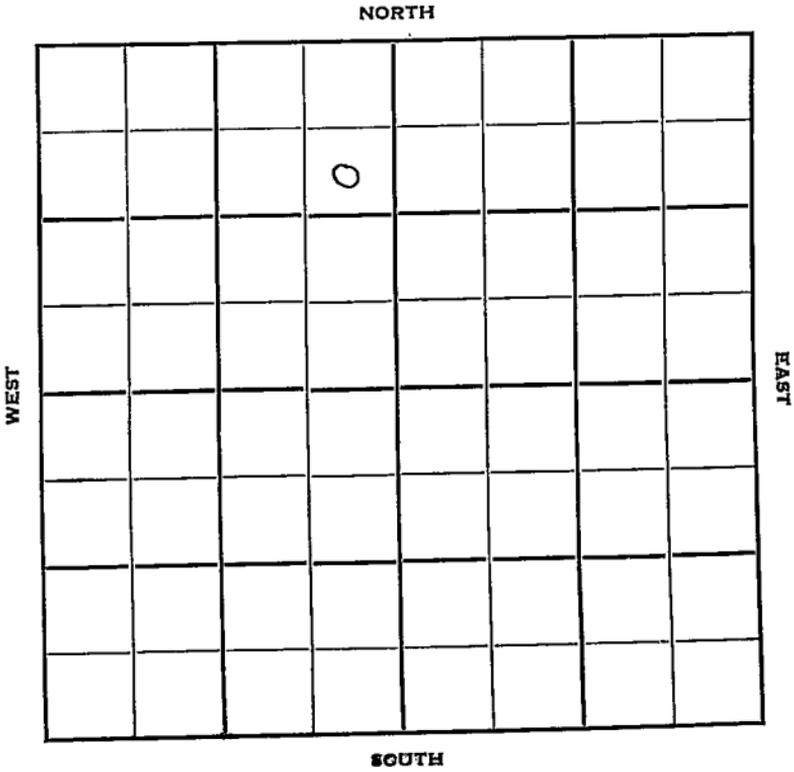

Rooks

KANSAS

Sec. 12 Twp. 10 R. 20 W ✓

Well No. # 4 Desbien Farm

Continental Oil Company

Berland Pool Contractor


990 Ft. from N. Line

Ft. from S. Line

330 Ft. from E. Line

Ft. from W. Line

SE NE NW

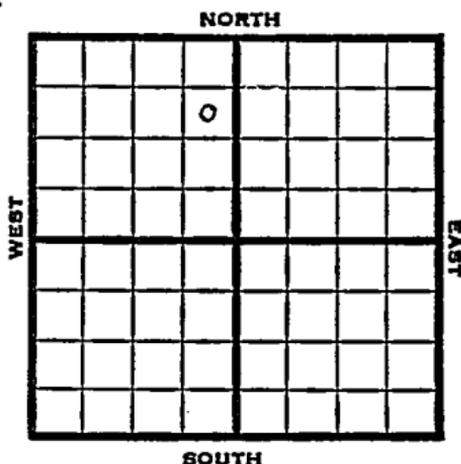

1951

Elev. 2225' REPORT

8/8

Spud 8-3-51
10" @ 334' WOC

10/3

Spud 8-3-51
Oil well TD 3762' 10" @ 334'
Heab 3426' Lans. 3465' Arb. 3753-5'
5" @ 3754' CO to 3757' DD 3762'
S/22 BOPH 16 hr. S/20 BOPH 12 hr.
S/429 BO 14 hr.
Comp. 696 BOPD

COMPLETED

County Rooks State Kansas

Sec. 12 (Blk. Twp.) 10 (Sur. Rge.) 20W Map No.

Operator Continental Oil

Well No. 4 Farm Desbien

Elev. 2225 Location SE NE NW

		0			
FIRST REPORT					

990 Ft. From N Line NW

330 Ft. From E Line Quarter

1st. Report AUG 8 1951

Completion _____

Remarks _____

Spudding Date 8-3-51

Drig. Data Berland Pool

10" @ 334 WOC

J. E. TYRA

