


Section 12 Township 10 Range 20W

Well No. #7 Desbien

Company Sohio

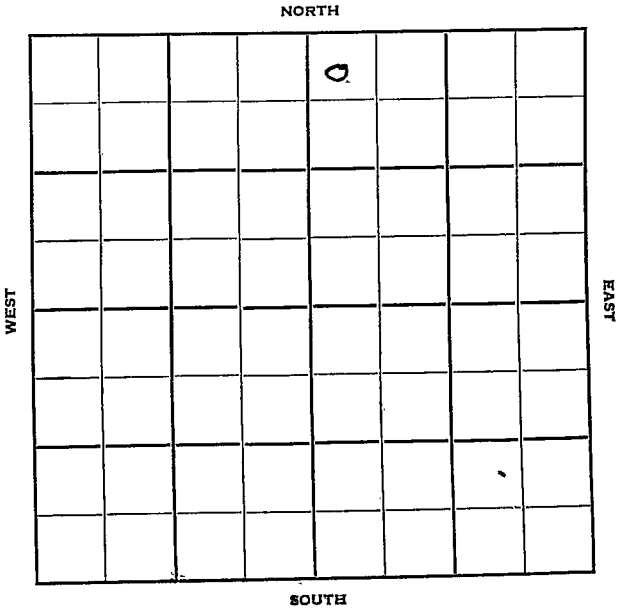

Rooks

KANSAS

12

10

20W

Sec. _____ Twp. _____ R. _____

#7 Desbien

Well No. _____ Farm _____

Sohio

Company _____

B & R Drlg.

Contractor _____

330

Ft. from N. Line

Ft. from S. Line


Ft. from E. Line

330

Ft. from W. Line

NE $\frac{1}{4}$

NW NW NE

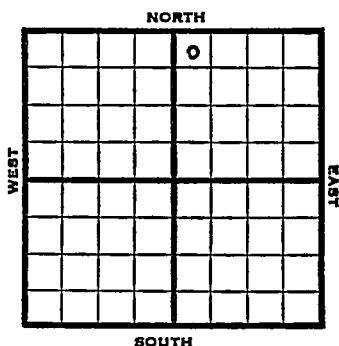

1952

Elev. 2227'

REPORT

11/12

Location

11/20

Anhy 1656'

11/27

Topeka 3237, Heeb 3443, Lans 3482

Drlg. 3604'

12/4

D&A HOLD

12/10

Spud 11-14-52

D & A TD 3844' 8" @ 116

Anhy 1656' Top. 3236' Heeb 3443'

Lans. 3481'

DST 3677-3706 open 1 hr. rec 20' oil

60' muddy oil, 60' MCW 630#

B KC 3699' Cong. 3743'

TD 3844' D & A

ABANDONED

Sec. 12 (Blk. Twp.) 10 (Sur. Rge.) 20W Map No.

Operator **Schio**

Well No. **7** Farm **Desbien**

Elev.	Location	NEW	NEW	NEW
-------	----------	-----	-----	-----

330 Ft. From III Line Quarter

1st. Report NOV 12 1952

Completion

Remarks _____

B & R Drlg. - Contr.

Spudding Date _____

Drlg. Data

Location

J. G. McGEHEE

J. G. McGEHEE