


Section 12 Township 10 Range 20W

Well No. #2 E. Suttor

Company Gulf

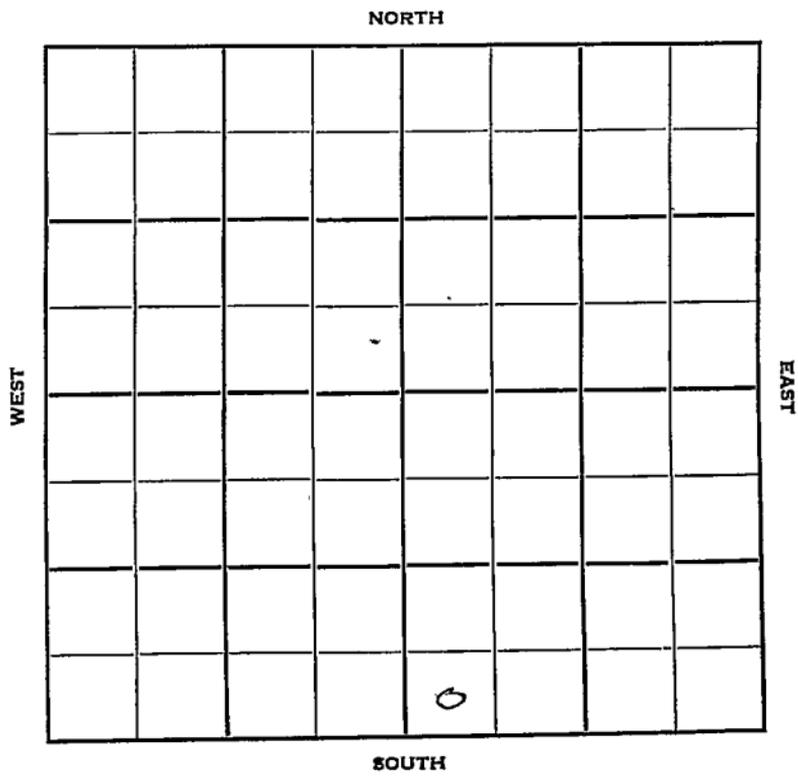

Rooks 10

KANSAS

Sec. 12 Twp. 10 R. 20W ✓

Well No. ~~#1~~ #2 E. Suttor Farm

Gulf Oil Company

Contractor

Berland Pool


_____ Ft. from N. Line

330' Ft. from S. Line

2310' Ft. from E. Line

_____ Ft. from W. Line

SW SW SE

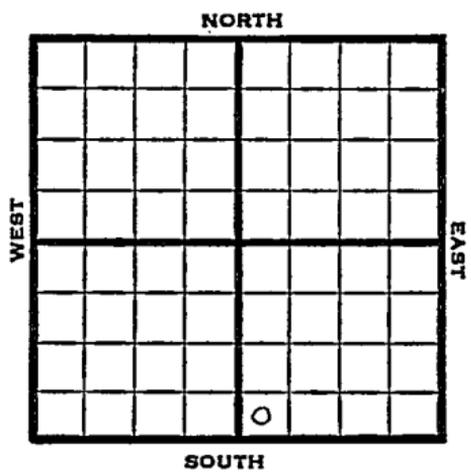

1950

Eleven 2222' REPORT

3/1

Spud 2-27-50
Anhy 1636'
Running 8" @ 1645'

4/19

TD 3776'
8" @ 1645'
Anhy 1636'
Heeb 3433'
Lans 3471'
Cong 3710'
Arb. 3772'
5" @ 3773'
451 BOPD

Comp
COMPLETED

Kansas

Berland Pool

Map No. _____ Sec. 12 Twp. 10 R. 20W

Well No. 1 E. Suttor

Gulf Oil Company

Contractor

SW SW SE

SECTION PLAT

_____ Ft. from N. Line

330 Ft. from S. Line

2310 Ft. from E. Line

_____ Ft. from W. Line



Rooks County

Location _____

Rig up _____

Drilling and Remarks:

Spud 2-27-50

Anhy 1636

running 8" @ 1645

RECORD

Cased _____ in., _____ ft.

Sand _____

Gas _____

Oil _____

Total Depth _____

PRODUCTION

1st 24 hrs. Nat. _____

1st 24 hrs. after shot _____

Gas _____ Cu. Ft.

Dry Hole _____

Abandoned _____

Date

MAR 1 1950 19

J. E. TYRA

Scout

KANSAS

Berland Pool

Map No. _____ Sec. 12 Twp. 10 R. 20W

Well No. 2 E. Suttor

Gulf Company

Contractor

SW SW SE

CORRECTION
El. 2222
SECTION PLAT

Erst

_____ Ft. from N. Line

330 Ft. from S. Line

2310 Ft. from E. Line

_____ Ft. from W. Line

Rooks County

Location _____

Rig up _____

Drilling and Remarks:

Reported

#1 E. Suttor

RECORD

Cased _____ in., _____ ft.

Sand _____

Gas _____

Oil _____

Total Depth _____

PRODUCTION

1st 24 hrs. Nat. _____

1st 24 hrs. after shot _____

Gas _____ Cu. Ft.

Dry Hole _____

Abandoned _____

Date

MAR 8 1950

J. E. TYRA

Scout

Map No. _____ Sec. 12 Twp. 10 R. 20WWell No. 2 E. Suttor

Gulf

Company

Contractor

SW SW SE


E. 2222

SECTION PLAT

_____ Ft. from N. Line

330 Ft. from S. Line2310 Ft. from E. Line

_____ Ft. from W. Line

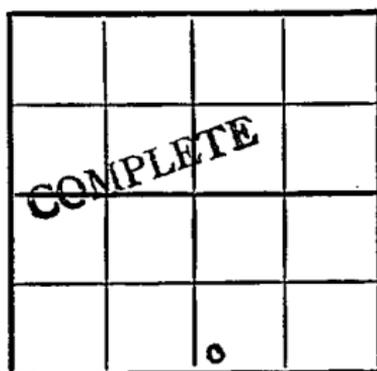

Recks County

Location _____

Rig up _____

Drilling and Remarks:

8' @ 1645
 anhy 1636
 Keel 3433
 Lams 3471
 Cmg 3710
 aht 3772

RECORD

Cased _____ in., _____ ft.

Sand _____

Gas _____

Oil _____

Total Depth 3776

PRODUCTION

1st 24 hrs. Nat. _____

1st 24 hrs. after shot _____

Gas _____ Cu. Ft.

Dry Hole _____

Abandoned _____

5" @ 3773

Date

451 BOPD

APR 19 1950 19

J. E. TYRA Scout