


Section 12 Township 10 Range 20-W

Well No. #3 Earl Suttor

Company Gulf Oil

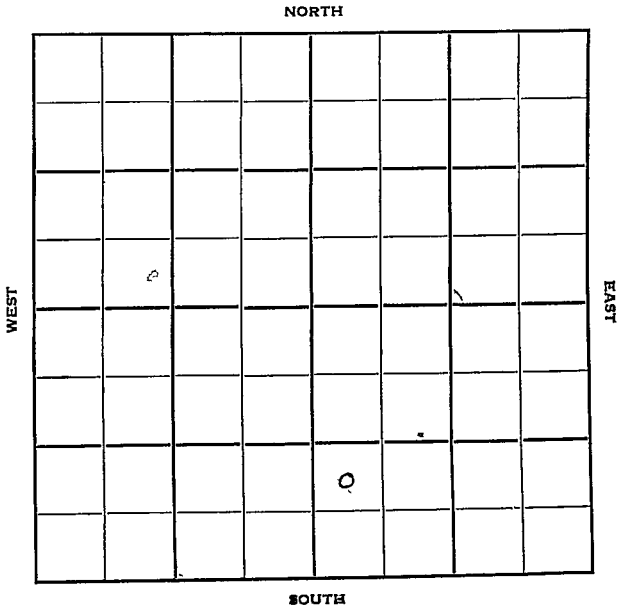

Rooks KANSAS
10

Sec. 12 Twp. R. 20W

Well No. #3 Earl Suttor Farm

Gulf Oil Company

Contractor


Ft. from N. Line

990' Ft. from S. Line

Ft. from E. Line

330' Ft. from W. Line

NW SW SE

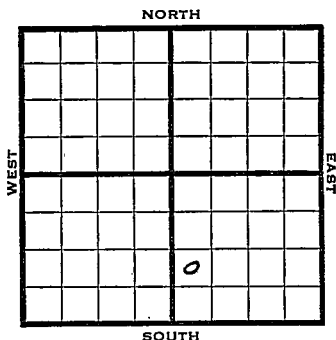

1950

Elev. 2229' REPORT

7/5

Spud 7-1-50

Drlg.

8/16

8" @ 1657

Heeb 3435

Lans 3474

DST 3623-53 opn 25 min rec 480' g 7 ocm

Arb 3765-70

5" @ 3766

CO to 3770 FU 2010' in 3 hr

S/116 bo 4 hr TD 3773 S/166 bo 4 hr

Comp 3000 bopd

Completed

COMPLETED

K: 7822

Map No. _____ Sec. 12 Twp. 10 R. 20 WWell No. 3 Earl SutterGulf Oil Company

Contractor


NW SE

E1. 2229
SECTION PLAT

_____ Ft. from N. Line

990 Ft. from S. Line

_____ Ft. from E. Line

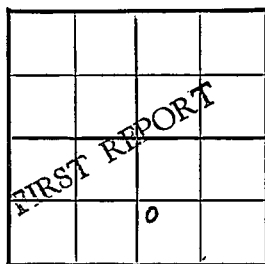330 Ft. from W. Line

Rooks County

Location _____

Rig up _____

Drilling and Remarks:

Spud 7-1-50

drlg.

RECORD

Cased _____ in., _____ ft.

Sand _____

Gas _____

Oil _____

Total Depth _____

PRODUCTION

1st 24 hrs. Nat. _____

1st 24 hrs. after shot _____

Gas _____ Cu. Ft.

Dry Hole _____

Abandoned _____

Date

JUL 5 1950

19

J. E. TYRA Scout

J. E. TYRA