

Section 12 Township 10 Range 20WWell No. #7 E. SutorCompany Gulf Oil

NORTH

							0

SOUTH

Rooks KANSAS

Sec. 12 Twp. 10 R. 20W ✓

Well No. #7 E. Sutor Farm

Gulf Oil Company

Herndon Drlg. -Contr. Contractor

Berland Pool


990' Ft. from N. Line

 Ft. from S. Line

330' Ft. from E. Line

 Ft. from W. Line

SE NE SE

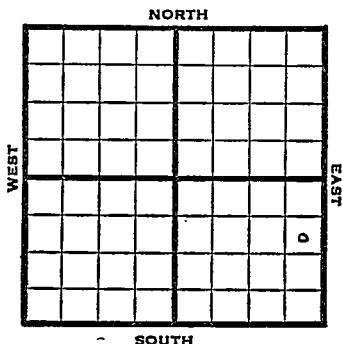

1950

Elev. 2227' REPORT

12/6

Spud 12-2-50
Drlg. 1535'

1951
1/10

Spud 12-2-50
Oil Well TD 3763
Anhy 1649 8" @ 1655
Heeb. 3425 Lans. 3461
BKC 3678 Cong. 3703
Viola 3725' Simp 3738
Arb. 3760'
TD 3763' S/96 bo 2 hrs
Comp. 3000 bopd

COMPLETED

Sec. **12** (Blk. Twp.) **10** (Sur. Rge.) **20W** Map No.

Well No. **7** Farm **E. Sutor**

Elev. 2227 Location SE NE SE

o

990 Ft. From **N** Line **SE**

330 Ft. From E Line Quarter

1st. Report DEC 6 1950

Completion

Remarks


Herndon Drlg. - Contr.

Spudding Date **12-2-50**

Drbg. Data Berland Pool

drlg. 1535

County _____ Rocks _____ State Kansas
 Sec. 12 (Blk. Twp.) 10 (Sur. Rge.) 20W Map No. _____
 Operator Gulf Oil
 Well No. 7 Farm E. Sutor
 Elev. 2227 Location SE NE SE

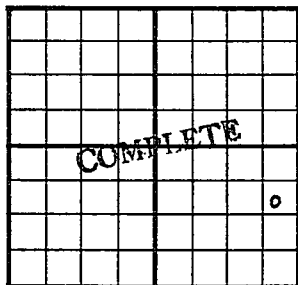

990 Ft. From N Line SE
330 Ft. From E Line Quarter
 Ist. Report _____
 Completion JAN 10 1951
 Remarks Berland Pool
Herndon Drlg. - Contr.
 Spudding Date 12-2-50

Drlg. Data Oil well TD 3763
Anhy 1649 8" @ 1655 Heeb. 3425
Lans. 3461 B KC 3678 Cong. 3703
Viola 3725 Simp. 3738 Arb. 3760
TD 3763 5" @ 3761 S/ 77 bo 4 hr.
500 A S/ 96 bo 2 hr.
Comp. 3000 bopd

J. E. TYRA