


Section 12 Township 10 Range 20W

Well No. #8 E.Sutor

Company Gulf

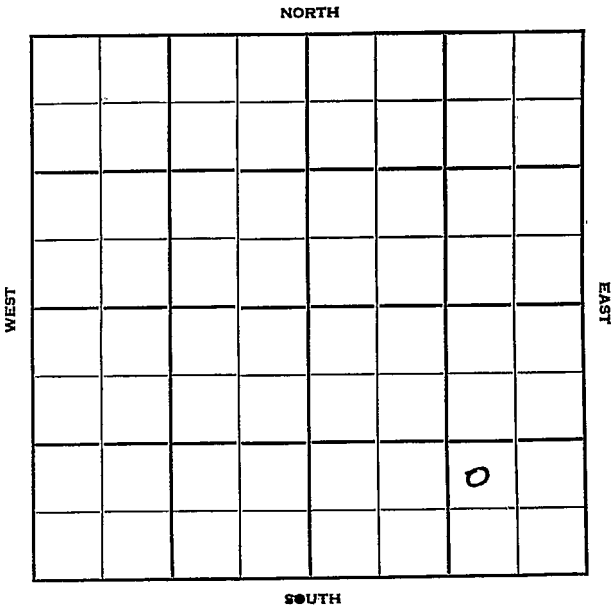

Rooks

KANSAS

Sec. 12 Twp. 10 R. 20W

Well No. #8 E. Sutor Farm

Gulf Company

Herndon Drlg. - Contr. Contractor

Berland Pool


 Ft. from N. Line

990' Ft. from S. Line

990' Ft. from E. Line

 Ft. from W. Line

NW SE SE

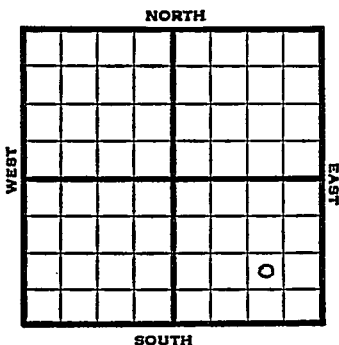

1951 Elev. 2215 REPORT

1/3 RUR

2/21

Spud 12-30-50

Oil well TD 3758

8" @1652

Heeb. 3419 Lans. 3457

DST 3498-3536 open $\frac{1}{2}$ hr. rec. 26' mud

DST 3605-50 open 1 hr. rec. 110' HOCM

Viola 3698 Simp. 3723 Arb. 3754-58

DST 3707-50 open 45 min. rec. 55' OCM

5" @3755 TD 3758 500 A S/174 bo

Comp. draw down pot. 3775 bopd

COMPLETED



(Blk.)
(Twp.)

Gulf

8

NW SE SE

FIRST REPORT

re


3

Completion

Remarks

Herndon Drlg. - Contr.

Spudding Date

Berland Pool

R U R

J. E. TYRA

J. E. TYRA -