


KANSAS

Section 12 Township 10 Range 20-W

Well No. #6 E. Sutor

Company Gulf Oil

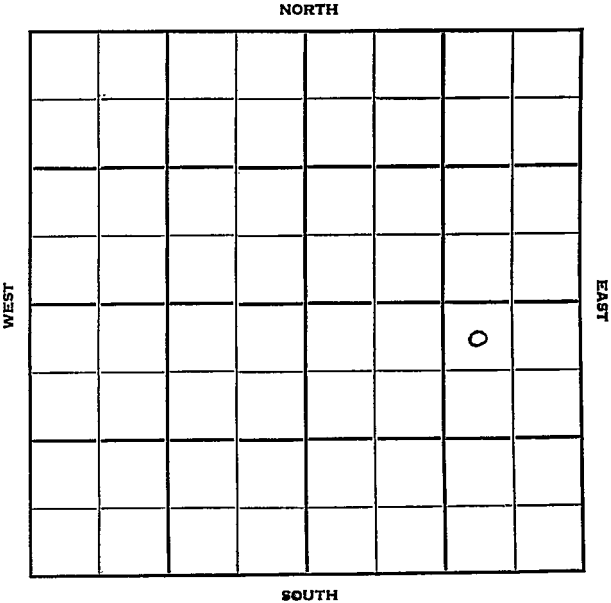

KANSAS

Rooks



Sec. 12 Twp. 10 R. 20-W

Well No. # 6 E. Sutor Farm

Gulf Oil Company

Herndon Drlg Contractor

Berland


330 Ft. from N. Line

_____ Ft. from S. Line

990 Ft. from E. Line

_____ Ft. from W. Line

NW NE SE

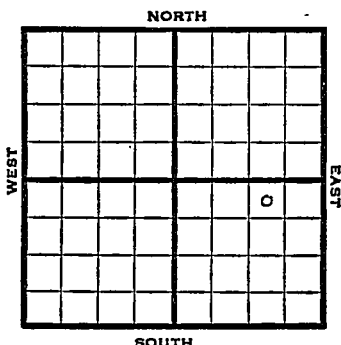

1950

Elev. 2234' REPORT

11/1

Location

12/6

Spud 10-30-50
Oil Well TD 3773'
Anhy 1660' 8" @ 1670
Heeb 3433' KC 3473
DST 3500-38 opn $\frac{1}{2}$ hr
Rec. 225' mud & sw trace of oil
Arb. 3765-68 5" @ 3766
S/54 bo 4 hr DD 3773
S/103 bo 4 hr PB 3770 500 A
S/117 bo 4 hr Comp. 3000 bopd

COMPLETED

County Rooks State Kansas
 Sec. 12 - (Blk. 10 (Sur. 20W Map No. 10)
 Operator Gulf Oil
 Well No. 6 Farm E. Sutor
 Elev. _____ Location NW NE SE

FIRST REPORT 0

330 Ft. From N Line SE
990 Ft. From E Line Quarter
 Ist. Report NOV 1 1940
 Completion _____
 Remarks _____
Herndon Drlg. - Contr.
 Spudding Date _____

Drlg. Data Berland Pool
Location

J. E. TYRA

County Rooks State **Kansas**

Sec. 12 (Blk. Twp.) 10 (Sur. Rge.) 20W Map No.

Operator Gulf Oil

Well No. 6 Farm E. Sutor

Elev.	2234	Location	NW NE SE
-------	------	----------	----------

330 Ft. From N Line SE

990 Ft. From E Line Quarter

Ist. Report

Completion DEC 6 1950

Remarks Berland Pool

Herndon Drlg. - Contr.

Spudding Date 10-30-50

Drilg. Data Oil well TD 3773

Anhy 1660 8" @ 1670 Heeb. 3433

KC 3473 DST 3500-38 open $\frac{1}{2}$ hr.

Rec. 225' mud & sw trace of oil Arb. 3765

68 5" @ 3766 S/ 54 bo 4 hr. DD 3773

S/ 103 bo 4 hr. PB 3770 500 A

S/ 117 bo 4 hr. Comp. 3000 bond