
O. W. P. B. KANSAS Rooks

FORM 51 25M 3-49 PETROL

Section 12 Township 10 Range 20-W

Well No. #4 Sutor "B"

Company Sohio et al

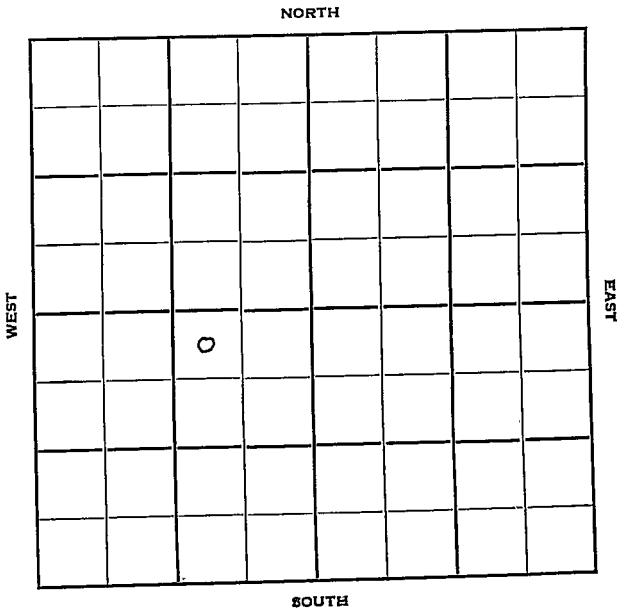

FORM 252-B
10M 9-49 PETRO

O. W. P. B.

KANSAS Rooks

Sec. 12 Twp. 10 R. 20-W

Well No. #4 Sutor "B" Farm

Sohio et al Company

Reserve Drlg. Contractor

Berland


330 Ft. from N. Line

Ft. from S. Line

990 Ft. from E. Line

Ft. from W. Line

NW NE SW

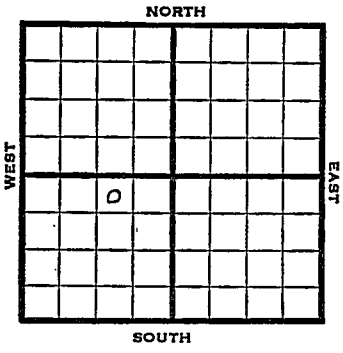

1950	Elev 2194 REPORT
7/19	MIM
9/20	Anhy 1620 8" @ 1629 Heeb 3408 Lans 3443 DST 3592-3625 opn 1 hr rec 13' ocm DST 3634-66 opn 1 hr rec 120' ho & gcm Cong 3681 Simp 3719 Arb 3737-39 5½" @ 3738 B/5 boph DD 3740 no inc. DD 3841 FU 500' oil 1 hr S/14 boph 5 hr Comp 227 bopd Completed **COMPLETED**
1951	O. W. P. B.
8/15	KC 3443' Cong 3681' Simp 3719' Arb. 3737' OTD 3741½' 5½" @ 3738½' PB 3682' 12/3648-51' 16/3641-45' 12/3632-35' 2000 A Testing
9/5	Oil Well TD 3682 KC 3443 Cong 3681 Simp 3719 Arb. 3737 OTD 3741 5½" @ 3738 PB 3682 12/3648-51 16/3641-45 12/3632-35 2000 A 2 boph 3000 A 60 bo 9 hr Comp. 122 bopd **COMPLETED**

Form 26 200 Bks. 11-49 Petrol

Berland Pool

Kansas

Map No. _____ Sec. 12 Twp. 10 R. 20W


Well No. 4 Sutor "B"

Sohio etal. Company

Reserve Drlg. Contractor

NW NE SW

SECTION PLAT

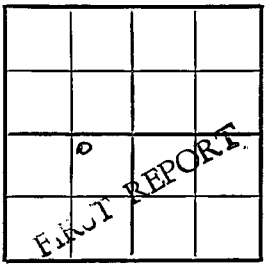

330 Ft. from N. Line

_____ Ft. from S. Line

990 Ft. from E. Line

_____ Ft. from W. Line

Rooks County

Location _____

Rig up _____

Drilling and Remarks:

M I M

RECORD

Cased _____ in., _____ ft.

Sand _____

Gas _____

Oil _____

Total Depth _____

PRODUCTION

1st 24 hrs. Nat. _____

1st 24 hrs. after shot _____

Gas _____ Cu. Ft.

Dry Hole _____

Abandoned _____

Date

JUL 19 1950

19 J. E. TYRA Scout

FORM 275 FOR SALE BY KANSAS BLUE PRINT CO.


County Rooks State Kansas

Sec. 12 (Blk. Twp.) 10 (Sur. Rge.) 2 OW Map No.

Operator Sohio etal.

Well No. 4 Farm Sutor "B"

Elev. 2193 Location NW NE SW

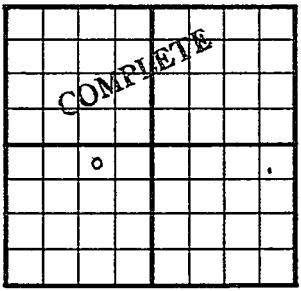

330 Ft. From N Line SW

990 Ft. From E Line Quarter

1st. Report ~~SEP 2 0 1950~~

Completion SEP 2 0 1950

Remarks

Berland Pool

Spudding Date

Drlg. Data Oil well TD 3741

Anhy 1620 8" @ 1629 Heeb. 3408

Lans. 3443 DST 3592-3625 open 1 hr.

Rec. 13' ocm DST 3634-66 open 1 hr.

Rec. 120' ho & gcm Cong. 3681

Simp. 3719 Arb. 3737-39 5½" @ 3738

B/ 5 goph DD 3740 ~~no~~ inc. DD 3741

FU 500' oil 1 hr. S/ 14 boph 5 hr.

Comp. 227 bopd

J. E. TYRA

FORM 275 FOR SALE BY KANSAS BLUE PRINT CO.


County Rooks State Kansas

Sec. 12 (Blk. Twp.) 10 (Sur. Rge.) 20W Map No.

Operator Sohio

Well No. 4 Farm Sutor "B"

Elev. 2194 Location NW NE SW

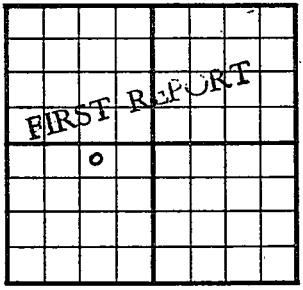

330 Ft. From N Line SW

990 Ft. From E Line Quarter

1st. Report AUG 15 1951

Completion

Remarks OWPB

O.W.P.B.

Spudding Date

Drlg. Data

KC 3443 Cong. 3681 Simp. 3719

Arb. 3737 OTD 3741½ 5½" @ 3738½

PB 3682 12/ 3648-51 16/ 3641-45

12/ 3632-35 2000 A testing

J. E. TYRA

FORM 275 FOR SALE BY KANSAS BLUE PRINT CO.


County Rooks State Kansas

Sec. 12 (Blk. Twp.) 10 (Sur. Rge.) 20W Map No.

Operator Sohio

Well No. 4 Farm Sutor "B"

Elev. 2194 Location NW NE SW

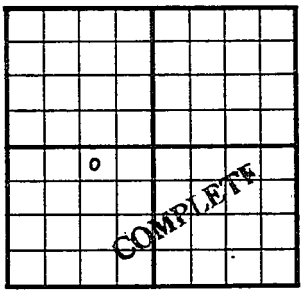

330 Ft. From N Line SW

990 Ft. From E Line Quarter

1st. Report

Completion SEP 5 1951

Remarks OWPB

Spudding Date

Drlg. Data Oil well TD 3682

KC 3443 Cong. 3681 Simp. 3719

Arb. 3737 OTD 3741 5½" @ 3738

PB 3682 12/ 3648-51 16/ 3641-45

12/ 3632-35 2000 A 2 boph 3000 A

60 bo 9 hr. Comp. 122 bopd

J. E. TYRA