

Section 12 Township 10 Range 20W

Well No. #6 Sutor "B"

Company Sohio et al

NORTH

WEST

EAST

SOUTH

0

Rooks

KANSAS

Sec. 12 Twp. 10 R. 20W ✓

Well No. #6 Sutor "B" Farm

Sohio et al Company

Rine Drlg. - Contr. Contractor


Berland Pool
Ft. from N. Line

330' Ft. from S. Line

1250' Ft. from E. Line

Ft. from W. Line

C S L S $\frac{1}{2}$ SW

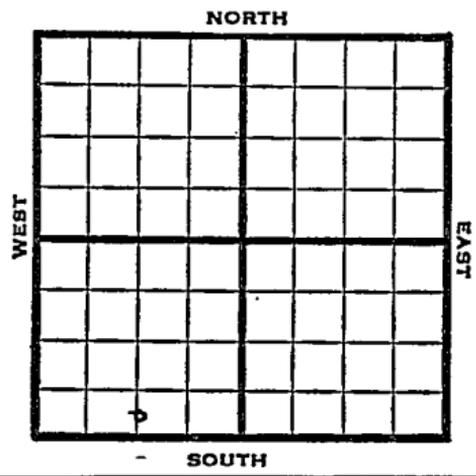


1950 Elev. 2205' REPORT

12/6 Spud 11-30-50
8-5/8" @ 312
Drlg. 2445'

1951
1/17 Spud 11-30-50
Oil Well TD 3761
8-5/8" @ 312' Top 3211 Heeb. 3418
Lans. 3455
DST 3490-3504 opn 45 min
Rec. 5' mud DST 3602-30 opn 1 hr
Rec. 50' ocm DST 3640-63 opn 1 hr
Rec. 210' mud cut oil & gas
Arb. 3754-57 5" @ 3756
TD 3761 B/62 goph 500 A
Depth pot. 1609 bopd

COMPLETED

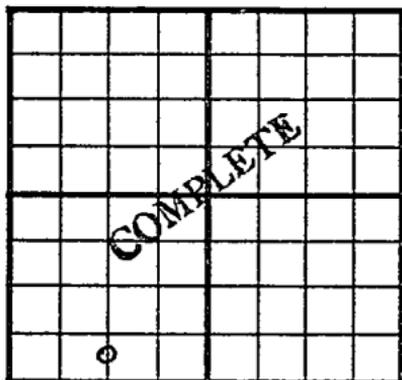County _____ Rocks _____ State KansasSec. 12 (^{Blk.}_{Twp.}) 10 (^{Sur.}_{Rge.}) 20W Map No. _____Operator Sohio etal.Well No. 6 Farm Sutor "B"Elev. 2205 Location C S L S $\frac{1}{2}$ SW330 Ft. From S Line SW1250 Ft. From E Line Quarter

Ist. Report _____

Completion JAN 17 1951Remarks Berland PoolRine Drlg. - Contr.Spudding Date 11-30-50Drlg. Data Oil well TD 37618 5/8" @ 312 Top. 3211 Heeb. 3418Lans. 3455 DST 3490-3504 open 45 min.Rec. 5' mud DST 3602-30 open 1/2 hr.Rec. 50' ocm DST 3640-63 open 1 hr.Rec. 210' mud cut oil & gas Arb. 3754-575" @ 3756 TD 3761 B/ 62 goph 500 ADepth. pot. 1609 bopd

J. E. TYRA