


Section 12 Township 10 Range 20W

Well No. #7 Sutor "B"

Company Sohio

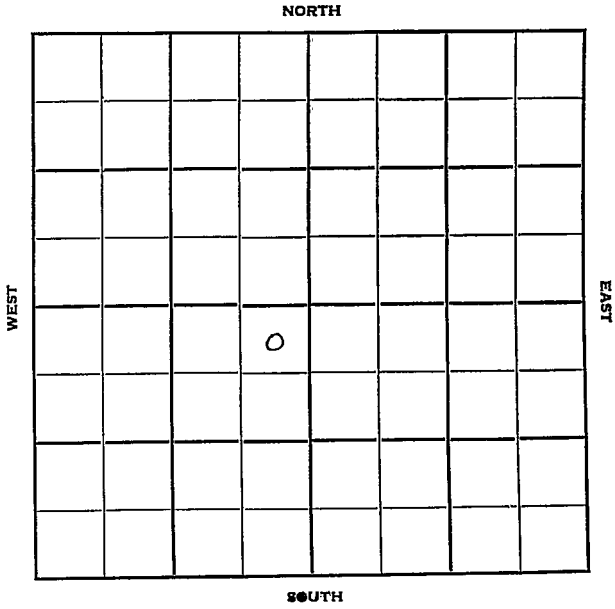

Sec. 12 Twp. 10 R. 20 W ✓

Well No. # 7 Sutor "B" Farm _____

Sohio Company

Reserve Drlg. Contractor


330 Ft. from N. Line

_____ Ft. from S. Line

330 Ft. from E. Line

_____ Ft. from W. Line

NE NE SW

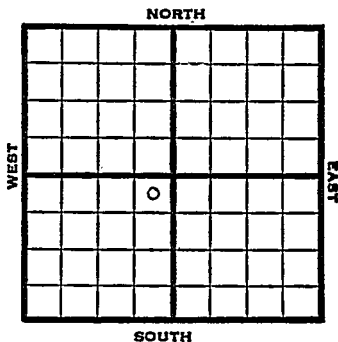

1951

Elev. 2220' REPORT

5/9

Spud 5-4-51
8" @ 310
Drlg. 1640'

6/20

Spud 5-4-51
Oil Well TD 3762
8" @ 310
Top 3218 Heeb. 3423
Lans. 3461 Simp 3728
Arb. 3752-62
5" @ 3759 CO to 3760
FU 120' oil 20 min
FU 1436 oil 2½ hr S/24 boph 9% wtr
Comp. 408 bopd 206% wtr.

COMPLETED

