


Rooks

KANSAS

SECTION 12 TOWNSHIP 10 RANGE 20WWELL NO. #8 Sutor "B"COMPANY Sohio

NORTH

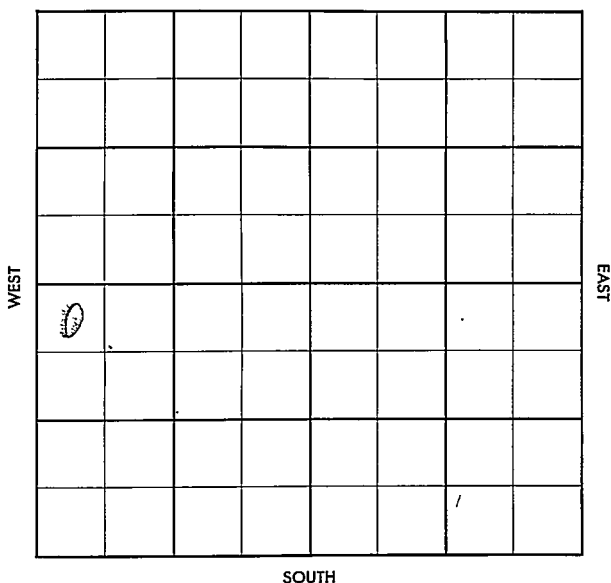

County Rooks Elev. 2222
 Sec. 12 Twp. 10 Rge. 20W
 Company Sohio
 FarmName Sutor "B" No. 8

TOPS	DEPTH	LOG	DATUM	Loc. in Sec.
Anh.	1660			NW NW SW
Tr.				
H.				
Tr.				
Dg.				
Bl.				
L.				Geol.
K.C.				Contr.
B.K.C.				Reserve
Ce.				Pool
C.				Marcotte
M.				
M.				
K.				
Mz.				
Mq.				
V.				
S.				
S.				
A.				
R.				
Pe.				
G.				
T.D.				

Geol.

Contr.

Reserve

Pool

Marcotte

DEC 19 1956		

FIRST REPORT

Date Comm. 12-10-568" @ 240/150 drlg. 2890

County Rooks Elev. 2222
 Sec. 12 Twp. 10 Rge. 20W
 Company Sohio
 FarmName Sutor "B" No. 8

TOPS	DEPTH	LOG	DATUM	Loc. in Sec.
Anh.	1660			NW NW SW
TP.				
H.	3449			
Tr.				
Dg.				
Bl.				
L.	3486			Geol.
K.C.				Contr.
B.K.C.				Reserve
Ce.				
C.	3746			Pool
M.				Marcotte
M.				
K.				
Mz.				
Mo.				
V.				
S. <u>36</u>	3800			ABANDONED
S.				
A.	3807			
R.				
Pe.				
G.				
T.D.	3828	3830		

Date Comm. 12-10-56

8" @ 240/150 drlg. 2890 DEC 26 '56 JAN 2 '57

DST 3816-28 45" rec 20' Md

BHP 930/30

D&A ~~HEAD~~