

Graham
10

KANSAS

21W ✓

Sec. 12 Twp. R.

Well No. #1 Bass Farm

G. & G. Drlg. Company

Wildcat Contractor


330' Ft. from N. Line

Ft. from S. Line

Ft. from E. Line

330' Ft. from W. Line

NW NW SW

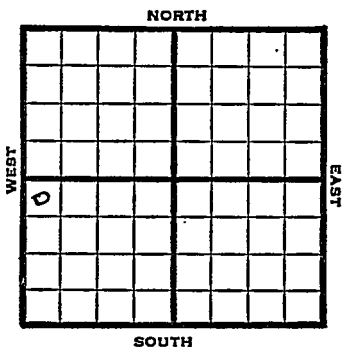

1950

Elev 2269

REPORT

5/24

Spud 5-22-50
Drlg. 230'

6/28

8 5/8" @ 203
Topeka 3283
Toronto 3505
B KC 3751
Simp 3809
5" @ 3827
TD 3833
S/8 boph
Comp 128 bopd
Completed

Heeb 3485
Lans 3526
Cong 3798
Arb 3826

COMPLETED

Kansas

Kansas

Map No. _____ Sec. 12 Twp. 10 R. 21WWell No. 1 Bass

G. & G. Drlg. _____ Company _____

_____ Contractor _____


NW NW SW

SECTION FLAT

330 Ft. from N. Line

_____ Ft. from S. Line

_____ Ft. from E. Line

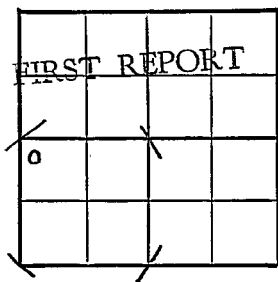330 Ft. from W. Line

Graham

Location _____

Rig up _____

Drilling and Remarks:

Spud 5-22-50.

Drlg. -230

RECORD

Cased _____ in., _____ ft.

Sand _____

Gas _____

Oil _____

Total Depth _____

PRODUCTION

1st 24 hrs. Nat. _____

1st 24 hrs. after shot _____

Gas _____ Cu. Ft.

Dry Hole _____

Abandoned _____

Date

MAY 24 1950 19J. E. TYRA Scout

ansas

Wildcat

Map No. _____ Sec. 12 Twp. 10 R. 21W

Well No. 1 Bass

C & G Drlg. Company

Contractor

NW NW SW


E1. 2269
SECTION PLAT

330 Ft. from N. Line

_____ Ft. from S. Line

_____ Ft. from E. Line

330 Ft. from W. Line

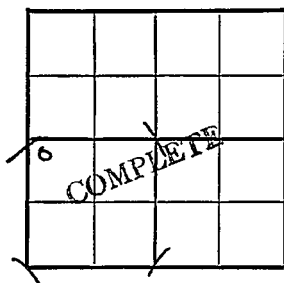

Graham County

Location _____

Rig up _____

Drilling and Remarks:

8 5/8" C 203

Topeka 3283

Heeb. 3485

Toronto 3505

Lans. 3526

B KC 3751

Cong. 3798

RECORD

Cased _____ in., _____ ft.

Sand _____

Gas _____

Oil _____

Total Depth 3833

PRODUCTION

1st 24 hrs. Nat. _____

1st 24 hrs. after shot _____

Gas _____ Cu. Ft.

Dry Hole _____

Abandoned _____

Date

JUN 28 1950 19

E. TVD Scout

Simp. 3809

Arb. 3826

5" @ 3827

TD 3833

S/ 8 boph

Comp. 128 bopd

3 1950

.....	Misc.
.....	Pierce Map
.....	France Map
.....	Tracings
.....	Land Wall Map
.....	Land Small Map
.....	Scout Cards

[Handwritten signature/initials across the table]

JUL 3 1950

.....

.....

