


Section 12 Township 10 Range 21W

Well No. #3 Bass

Company C & G Drlg. & Hanson

NORTH

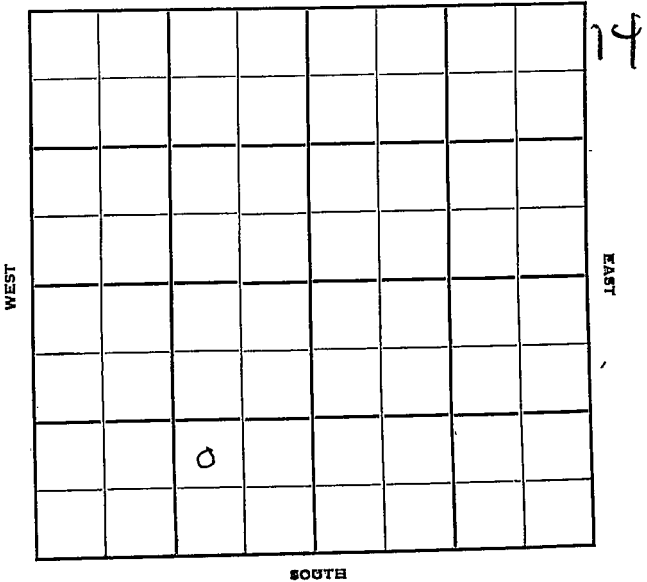

SOUTH

Graham **KANSAS**

Sec. 12 Twp. 10 R. 21W

Well No. #3 Bass Farm

C & G Drlg. & Hanson Company

C & G Drlg. Contractor

Bass Pool


_____ Ft. from N. Line

990' Ft. from S. Line

990' Ft. from E. Line

_____ Ft. from W. Line

NW SE SW

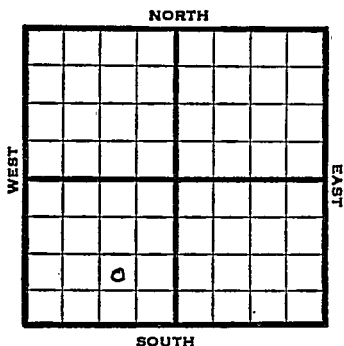

1950 **REPORT**

Elev 2279

9/13 Spud 9-11-50
8" @ 255'

10/24 Anhy 1755-90 Top 3287
DST 3313-20 opn $\frac{1}{2}$ hr rec 150' water
Heeb 3488 Toronto 3510
Lans 3531 B K/c 3756
Simp 3807 Arb 3813
TD 3819
5" @ 3814 $\frac{1}{2}$
750 A S/8 boph
DD 3822
1500 A S/12 boph
TD 3822
Comp 263 bopd
Completed
COMPLETED

County Graham State Kansas

Sec. 12 (Blk. 10) (Sur. 21W) Map No.

Operator C & G Drlg. & Hanson

Well No. 3 Farm Bass

Elev. 2279 Location NW SE SW

990 Ft. From S Line SW

990 Ft. From E Line Quarter

1st. Report

Completion OCT 25 1950

Remarks Bass Pool

C & G Drlg. - Contr.

Spudding Date 9-11-50

Drlg. Data Oil well TD 3822

8" @ 255 Anhy 1755-90 Top. 3287

DST 3313-20 open 1/2 hr. Rec. 150' water

Heeb. 3488 Toronto 3510 Lans. 3531

B KC 3756 Simp. 3807 Arb. 3813

TD 3829 5" @ 3814 1/2 750 A S/ 8 boph

DD 3822 1500 A S/ 12 boph

Comp. 263 bopd

J. E. TYRA