

Well No. # 7 Bass

Company C-G Drilling Co.

WEST

EAST

SOUTH

13

Graham

KANSAS



Sec. 12 Twp. 10 R. 21 W

Well No. # 7 Bass Farm

C-G Drilling Co. Company

C-G Drilling Contractor
Bass


 Ft. from N. Line

990 Ft. from S. Line

 Ft. from E. Line

660
990 Ft. from W. Line

~~NE SW SW~~
C 7 1/2 Sw Sw

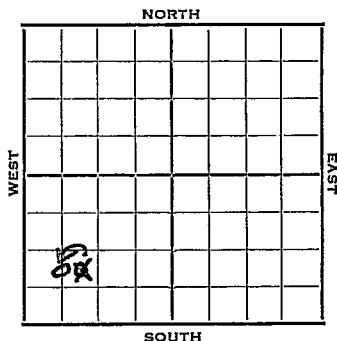

1952 Elev. 2277' REPORT

6/11 Spud 6-7-52
8" @ 157'
Drlg. 1510'

6/18 Heeb 3487' Tor. 3509' Lans. 3530'
DST 3603-3615, 50 mins, 640' Wtr.
Drlg. 3700'

6/25 B KC 3750' Simp. 3797' Arb. 3806'
RTD 3813' 5" @ 3808' DP 3813' VSSO
1000 A S/8 BOPH


7/2 NR

7/9 NR

7/16 Spud 6-7-52
Oil well TD 3813' 8" @ 157'
Anhy 1749' Heeb 3487' Tor. 3509'
Lans. 3530'
DST 3603-3615 open 50 min, rec 640'
water. B KC 3750' Simp. 3797'
Arb. 3806' TD 3813 5" @ 3808
DP to 3813 VSSO 1000 A
S/8 BOPH
Comp. 364 BOPD

COMPLETED

County Graham State Kan sas
 Sec. 12 (Blk. 10 (Sur. 21W Map No.
 Twp.) Rge.)
 Operator C-G Drilling Co.
 Well No. 7 Farm Bass
 Elev. Location NE SW SW

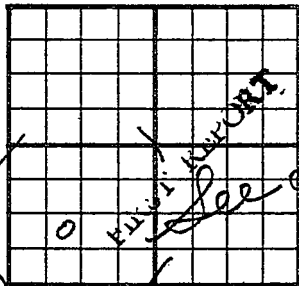

990 Ft. From S Line SW
990 Ft. From W Line Quarter

Ist. Report JUN 1 1952

Completion Production

Remarks

C-G Drlg. - Contr.

Spudding Date 6-7-52

Drlg. Data Bass

8" @ 157 - Drlg. 1510

J. G. McGEHEE

Kansas

Map No. _____ Sec. 12 Twp. 10 R. 21WWell No. 7 Bass

_____ C & G Drlg. _____ Company

CORRECTION _____ Contractor

C N L SW SW

SECTION PLAT

0			

_____ Ft. from N. Line

990 Ft. from S. Line

_____ Ft. from E. Line

660 Ft. from W. Line

Graham County

Location _____

Rig up _____

Drilling and Remarks:

Reported

NE SW SW

RECORD

Cased _____ in., _____ ft.

Sand _____

Gas _____

Oil _____

Total Depth _____

PRODUCTION

1st 24 hrs. Nat. _____

1st 24 hrs. after shot _____

Gas _____ Cu. Ft.

Dry Hole _____

Abandoned _____


Date

JUN 11 1952 19

J. G. McGEHEE

Scout

County Graham State Kansas
 Sec. 12 (Blk.) 10 (Sur.) 21W Map No.
 Operator C & G Drlg.
 Well No. 7 Farm Bass
 Elev. 2277 Location C N L SW SW

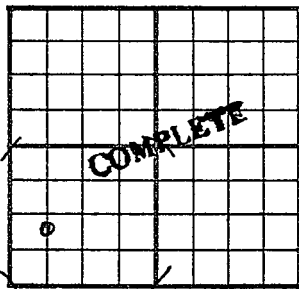

990 Ft. From S Line SW
660 Ft. From W Line Quarter
 Ist. Report
 Completion JUL 16 1952
 Remarks Bass Pool
C & G Drlg. - Contr.
 Spudding Date 6-7-52

Drlg. Data Oil well TD 3813
8" @ 157 Anhy 1749 Heeb. 3487
Tor. 3509 Lans. 3530 DST 3603-3615
open 50 min. Rec. 640' water
B KC 3750 Simp. 3797 Arb. 3806
TD 3813 5" @ 3808 DP to 3813 VSSO
1000 A S/ 8 boph Comp. 364 bopd

J. G. McGEHEE