


DX 78-1

Graham

Section 12 Township 10 Range 21W

Well No. (~~#2~~ ~~#3~~) Hunt-Beherns

Company C & G Drlg. & D. G. Hansen

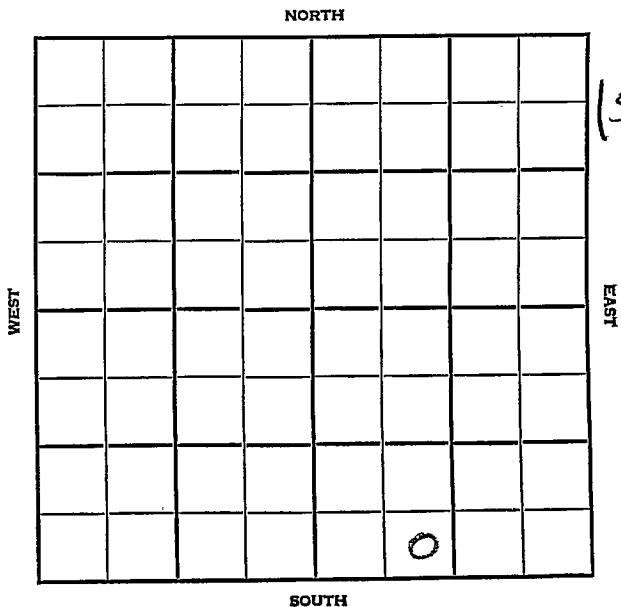

Graham

KANSAS

SEC. 12	TWP. 10	R. 21W
---------	---------	--------

WELL NO. ~~5-2-3~~ ~~5-3~~ Hunt-Heberns

FARM

COMPANY C & G Drlg & D. G. Hansen

CONTRACTOR

Co. Tools

Cooper Pool


_____ Ft. from N. Line

330' _____ Ft. from S. Line

_____ Ft. from E. Line

990' _____ Ft. from W. Line

SE SW SE

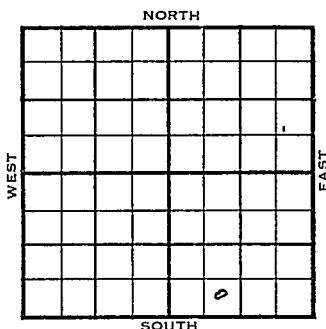

1955

ELEVATION

2266'

REPORT

5/25

Location

8-24

8 5/8" @ 170/150

5 1/2" @ 3839

DST 3839-56 open 1hr., rec. 185' gas 535'
 oil 60' hocom 0# CO to 3856 FU 850' oil
 4 hr. S/3.51 boph 3 hr. Comp. 73 bopd.
 Tp. 3297, 1031, H. 3504, 1238, Tr. 3529,
 1263, L. 3547, 1281, B.K.C. 3769, 1503,
 C. 3816 1550, A 3837, 1571, T.D. 3856

COMPLETED

Elev.	Location	SE	SW	SE
-------	----------	----	----	----

FIRST REPORT

Spudding Date _____

Location

K-5

SCOUT TICKET

DX-201

Kansas

SEC.

12

TWP.

10

R.

21W

WELL NO.

2 Hunt-Beherns

FARM

COMPANY

C & G Drlg. & D. G. Hansen

CONTRACTOR

CORRECTION

SE SW SE

____ FT. FROM N. LINE


330

____ FT. FROM S. LINE

____ FT. FORM E. LINE

990

____ FT. FROM W. LINE

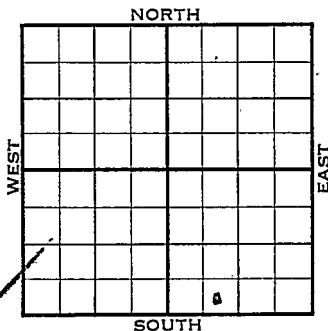

Graham County

☐

LOCATION

☐

RIG UP

DRILLING AND REMARKS:

Reported

#3 Hunt-Beherns

RECORD

CASED IN.. FT.

SAND

GAS

OIL

TOTAL DEPTH

1ST 24 HRS. NAT.

1ST 24 HRS. AFTER SHOT

GAS CU. FT.

DRY HOLE

ABANDONED

PRODUCTION

DATE

JUN 15 1955

SCOUT

L. J. Harris

SCOUT TICKET

DX-201

Kansas

SEC.

12

TWP.

10

R.

21W

WELL NO.

3 Hunt-Beherns

FARM

COMPANY

C & G Drlg. & D. G. Hansen

CONTRACTOR

CORRECTION

SE SW SE

____ FT. FROM N. LINE


330

____ FT. FROM S. LINE

____ FT. FORM E. LINE

990

____ FT. FROM W. LINE

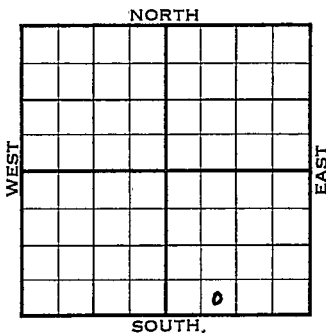

Graham County

☐

LOCATION

☐

RIG UP

DRILLING AND REMARKS:

Recorrected
from #2

RECORD

CASED IN., FT.

SAND

GAS

OIL

TOTAL DEPTH

PRODUCTION

1ST 24 HRS. NAT.

1ST 24 HRS. AFTER SHOT

GAS CU. FT.

DRY HOLE

ABANDONED

DATE

AUG 10 1955

SCOUT

L. J. Harris

County	Graham	Elev.	2266
Sec.	12	Twp.	10
Company	C & G Drilling & D.	G. Hansen	
Farm Name	Hunt-Behrens	No.	3

TOPS	DEPTH	LOG	DATUM	Loc. in Sec.
Anh.				SE SW SE
Tr.	3297		1031	
H.	3564		1238	
Tr.	3529		1263	
Dg.				
BL.				
L.	3547		1281	Geol.
K.C.				Contr.
B.K.C.	3769		1573	Co. tools
Ce.	3816		1530	Pool
C.				Cooper
M.				
M.				
K.				
Mz.				
Me.				
V.				
S.				
S.				
A	3837		1571	
R.				
Pe.				
G.				
T.D.	3856			

Date Comm.	5-25-55	AUG 24 1955
8 5/8" @ 170/150	5 1/2" @ 3839	
DST 3839-56	open 1 hr.	Rec. 185' gas
535' oil	60' hocm	0# CO to 3856
FU 850' oil	1 hr.	S/ 3.51 boph 3 hr.
Comp.	73 bopd	

COMPLETE