

Graham

KANSAS

SECTION 12 TOWNSHIP 10 RANGE 21 W

WELL NO. #5 Hunt-Behrens

COMPANY Cook & Galloway & D. G. Hansen

NORTH

							0

16

WEST

EAST

SOUTH

Graham

KANSAS

SEC.

12

TWP.

10

R.

21W

WELL NO.

#5 Hunt-Behrens

FARM

COMPANY

Cook & Galloway & D.G. Hansen

CONTRACTOR

Co. tools


_____ Ft. from N. Line

_____ Ft. from S. Line

_____ Ft. from E. Line

_____ Ft. from W. Line

NE SE SE

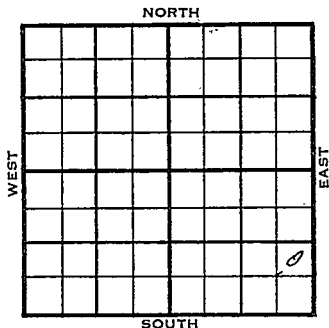

1956

ELEVATION

REPORT

1-11

Comm. 1-8-55
8" @ 18/165
Drlg. 1525

County Graham Elev. _____
 Sec. 12 Twp. 10 Rge. 21W
 Company Cook & Galloway & D. G. Hansen
 FarmName Hunt-Behrens No. 5

Co.

TOPS	DEPTH	LOG	DATUM
Anh.			
Ip.			
H.			
Tr.			
Dg.			
Bl.			
L.			
K.C.			
B.K.C.			
Ce.			
C.			
M.			
M.			
K.			
Mz.			
Mq.			
V.			
S.			
S.			
A.			
R.			
PE.			
G.			
T.D.			

Loc. in Sec. NE SE SE

Geol. _____

Contr. Co. tools

Pool _____

FIRST REPORT
 JAN 11 1956

Loc.

No.

Sec.

T.

R.

Date Comm. 1-8-56
8" @ 18/165 drlg. 1525

County Graham Elev. 2240 D7
 Sec. 12 Twp. 10N Rge. 21W
 Company Cook & Galloway & D. G. Hansen
 Farm Name Hunt-Behrens No. 5

TOPS	DEPTH	LOG	DATUM	Loc. in Sec.
Anh.	1753			NE SE SE
Ip.				E
H.	3476			
Tr.	3501			
Dg.				
Bl.				
L.	3518		1278	Geol.
K.C.				Contr.
B.N.C.				Co. tools
Ce.				Pool
C.				
M.				
M.				
K.				
Mz.				
Me.				
V.				
S.				
S.	3813'		1578	COMPLETE
A.				
R.				
PE.				
G.				
TD.	3824			

Date Comm. 1-8-56 FEB 15 1956

8" @ 18/165 drlg. 1525 JAN 18 '56 ϕ 3822

JAN 25 '56 DST 3814-24 1 hr rec.

340' GIP rec 740' oil + 800' Md
 oil BHP 600? 5 1/2 3814 FEB 1 '56

COTD.FU 800' oil 2 hrs 1/4

\$ 10 Bopk no/w 4 hrs

300' a.d. FEB 8 '56 FEB 15 '56 \checkmark Pkt

66 Bopd no/w 5