

Section 12 Township 10 Range 21 WWell No. # 2 Sutor-ShieldsCompany D. G. Hansen

NORTH

		0					
		1					

SOUTH

3

WEST

EAST


Sec. 12 Twp. 10 R. 21WWell No. #2 Sutor - Shields FarmD.G. Hansen CompanyC & G Drlg. ContractorCooper Pool330 Ft. from N. Line

Ft. from S. Line

Ft. from E. Line

990 Ft. from W. Line

NW NE NW

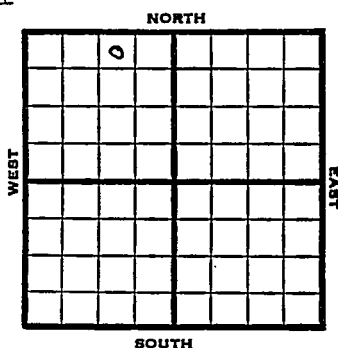

1952 Elev. 2264' REPORT

11/18 Spud 11-17-52
8" @ 166'

11/27 NR

12/4 Heeb 3476 Tor 3497 Lans 3516 BKC 3740
Cong 3795 Wea Simp 3804 Arb 3818
RTD 3824 5" @ 3820

12/11 RUST

12/18 CO 3824 B/35 GOPH 500A S/4½ BOPH POP

12/25 " " " " "

1/1 NR

1/8 NR

1/22 NR

1/28 Spud 11-17-52

Oil Well

TD 3824

8" @ 166

Heeb 3476, Tor 3497, Lans 3516,
B KC 3740, Cong 3795, Weathered
Simp. 3804, Arb. 3818

TD 3824

5" @ 3820

CO to 2824 B/35 goph 500A

S/4½ boph

Comp. 74 bopd

COMPLETED

County Graham State Kansas
 Sec. 12 (Blk. Twp.) 10 (Sur. Rge.) 21W Map No. _____
 Operator D. G. Hansen
 Well No. 2 Farm Sutor - Shields
 Elev. _____ Location NW NE NW

		0					

FIRST REPORT

330 Ft. From N Line NW
990 Ft. From E Line Quarter
 1st. Report NOV 19 1952
 Completion _____
 Remarks G & G Drlg. - Contr.
 Spudding Date 11-17-52

Drlg. Data Cooper Pool
8" @ 166

J. G. McGEHEE

County Graham State KansasSec. 12 (Blk.) 10 (Sur. Rge.) 21W Map No. _____Operator D. G. HansenWell No. 2 Farm Sutor - ShieldsElev. 2264 Location NW NE NW

		0					

330 Ft. From N Line NW990 Ft. From E Line Quarter1st. ReportCompletion JAN 28 1953Remarks Cooper PoolC & G Drlg. - Contr.Spudding Date 11-17-52Drlg. Data Oil well TD 38248" @ 166 Heeb. 3476 Tor. 3497Lens. 3516 B KC 3740 Cong. 3795Weathered Simp. 3804 Arb. 3818TD 3824 5" @ 3820 CO to 2824B/ 35 goph 500 A S/ 4½ bophComp. 74 bopd