


Section 12 Township 10 Range 21W

Well No. 4 Shields - Sutor

Company D. G. Hansen

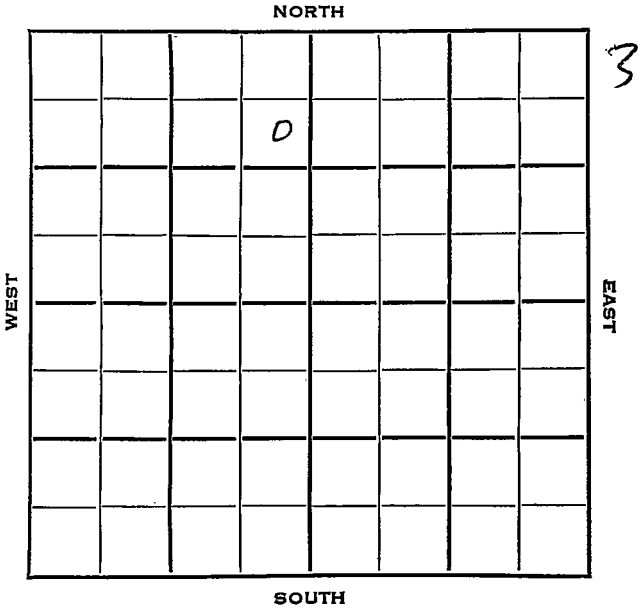

Graham

KANSAS

Sec. 12 Twp. 10 R. 21W

Well No. #4 Shields - Sutor Farm

D. G. Hansen Company


C & G Drlg. Contr. Contractor

990 Ft. from N. Line

Ft. from S. Line

330 Ft. from E. Line

Ft. from W. Line

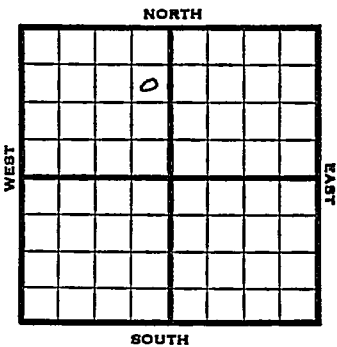

SE NE NW

1953 Elev. 2261' REPORT

3/4 Drlg. 300 (Spudded 2/28/53)
 3/12 8" @ 161 Anhy 1725 Heeb 3491
 Tor 3515 Lans 3532
 Drlg. 3665

3/18 D&A
 TD 3865
 8" @ 161
 Anhy 1725, Heeb 3491, Tor
 3515, Lans 3532, B KC 3754,
 Gong 3802, Simp 3835, Arb
 3844
 DST 3846-50, opn 1 hr., rec.
 12' mud, 3' oil, 0#
 DST 3848-55, opn 1-hr., rec.
 3' oil, 18' mud, 465#
 DST 3850-60, opn 1 hr., r ec.
 28' mud, 0#
 TD-3865
 D&A

ABANDONED

County Graham State Kansas

Sec. 12 (Blk. Twp.) 10 (Sur. Rge.) 21W Map No.

Operator D. G. Hansen

Well No. 4 Farm Shields-Sutor

Elev. 2261 Location SE NE NW

| | | | | | |
|--|--|--|--|--|--|
| | | | | | |
| | | | | | |
990 Ft. From N Line NW

330 Ft. From E Line Quarter

1st. Report

Completion MAR 1 8 1953

Remarks

C & G Drlg. - Contr.

Spudding Date 2-28-53

Drlg. Data D & A TD 3865

8" @ 161 Anhy 1725 Heeb. 3491

Tor. 3515 Lans. 3532 B KC 3754

Cong. 3802 Simp. 3835 Arb. 3844

DST 3846-50 open 1 hr. Rec. 12' mud

3' oil 0# DST 3848-55 open 1 hr.

Rec. 3' oil 18' mud 465# DST 3850-60

open 1 hr. Rec. 28' mud 0# TD 3865

D & A