


Section 12 Township 10 Range 21W

Well No. 6 Sutor-Shields

Company D. G. Hansen

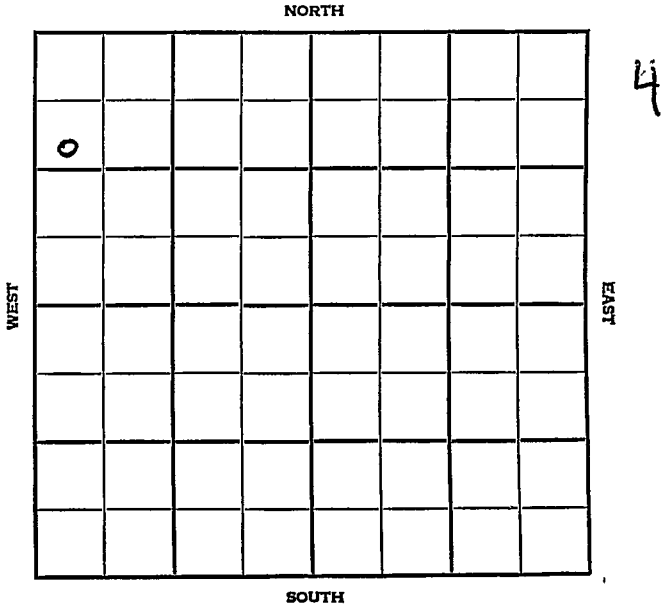

**Graham KANSAS**


|      |      |      |
|------|------|------|
| SEC. | TWP. | R.   |
| 12   | 10   | 21 W |

WELL NO. # 6 Sutor-Sheilds FARM

COMPANY D. G. Hansen

CONTRACTOR C & G Drlg.  
Cooper Pool

1150 Ft. from N. Line  
 \_\_\_\_\_ Ft. from S. Line  
 \_\_\_\_\_ Ft. from E. Line  
 330 Ft. from W. Line

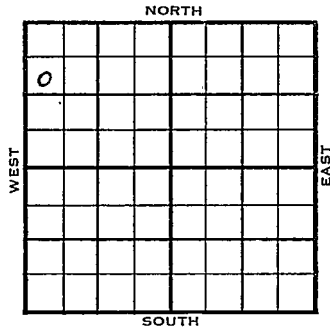

SW NW NW

|      | ELEVATION | REPORT |
|------|-----------|--------|
| 1954 | 2282'     |        |

10/13 Spud 10-8-54  
 8" @ 170 Anhy 1756  
 Drlg. 3250'

10/20 Spud 10-8-54 - D&A  
 td 3950'  
 8" @ 170'  
 Anhy 1756', <sup>T</sup>op 3306'; Heeb 3516',  
<sup>T</sup>or 3538', Lans 3555', B KC 3786',  
 Cong. 3848', Arb. 3933'  
 TD 3950'  
 D&A

**ABANDONED**

County Graham State Kansas

Sec. 12 (Blk. Twp.) 10 (Sur. Rge.) 21W Map No.

Operator D. G. Hansen

Well No. 6 Farm Sutor-Shields

Elev. 2282 Location SW NW NW

|   |  |  |  |  |  |
|---|--|--|--|--|--|
|   |  |  |  |  |  |
| o |  |  |  |  |  |
|   |  |  |  |  |  |
|   |  |  |  |  |  |
|   |  |  |  |  |  |
|   |  |  |  |  |  |
|   |  |  |  |  |  |
|   |  |  |  |  |  |

1150 Ft. From N Line NW

330 Ft. From W Line Quarter

1st. Report OCT 13 1954

Completion \_\_\_\_\_

Remarks \_\_\_\_\_

C & G Drlg. - Contr.

Spudding Date 10-8-54

Drlg. Data Cooper Pool

8" @ 170 Anhy. 1756 drlg. 3250

FABEN GILSTRAP

County Graham State Kansas

Sec. 12 (Blk. Twp.) 10 (Sur. Rge.) 21W Map No.

Operator D. G. Hansen

Well No. 6 Farm Sutor-Shields

Elev. 2282 Location SW NW NW

|                  |  |  |  |  |  |
|------------------|--|--|--|--|--|
|                  |  |  |  |  |  |
| 0                |  |  |  |  |  |
|                  |  |  |  |  |  |
|                  |  |  |  |  |  |
| <b>ABANDONED</b> |  |  |  |  |  |
|                  |  |  |  |  |  |
|                  |  |  |  |  |  |
|                  |  |  |  |  |  |
|                  |  |  |  |  |  |

1150 Ft. From N Line NW

330 Ft. From W Line Quarter

1st. Report

Completion OCT 20 1954

Remarks Cooper Pool  
C & G Drlg. - Contr.

Spudding Date 10-8-54

Drlg. Data D & A TD 3950

8" @ 170 Anhy 1756 Top. 3306

Heeb. 3516 Tor. 3538 Lans. 3555

B KC 3786 Cong. 3848 Arb. 3933

TD 3950

D & A

FABEN OIL STRAP