

Graham


DX 78-1

KANSAS

Section 12 Township 10 Range 23W

Well No. #1 Erwin

Company Heathman & Seeligson

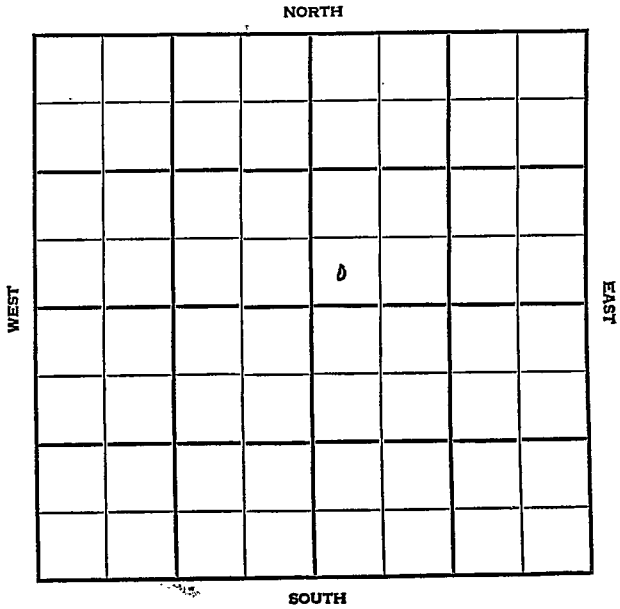

Graham KANSAS

SEC.	TWP.	R.
12	10	23W

WELL NO.

1 Erwin

FARM

COMPANY

Heathman & Seeligson

CONTRACTOR

Co. Tools


Wildcat

Ft. from N. Line

330 Ft. from S. Line

Ft. from E. Line

330 Ft. from W. Line

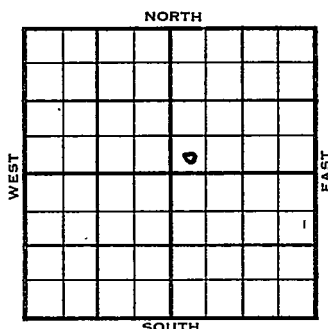

SW SW NE

Continental - AC

	ELEVATION	REPORT
1955	2409'	
1/19	Spud 1-15-55 8" @ 156'	
	Anhy 1948'	
	Drlg. 2345'	
3/9	Spud 1-15-55 Oil Well TD 4200'	
	8" @ 156'	
	Anhy 1948' Heeb 3650' Tor. 3670'	
	Lans 3687'	
	DST 3687'-3710' opn 1 hr, rec 360'	
	vsocw 1260#	
	DST 3718'-27' opn 1 hr, rec 30' ocm	
	60' mco, 1020#	
	DST 3772'-82' opn 1 hr, rec 70' msw,	
	1090#	
	DST 3825'-38' opn 1 hr, rec 190' s.w.	
	1330#	
	DST 3846'-58' opn 2 hr, rec 2200' gas	
	rec 510' oil, 1045#	
	DST 3861'-78' opn 45 min, rec 15' Mud	
	0#	
	DST 3881'-96' opn 1 hr, rec 20' Mud	
	75# B KC 3915' Marm 4001', Cong. 4088'	
	DST 4080'-98' opn 2 hr, rec 850' free	

OVER

1955

Information brought forward.

3/9

oil 1075#

DST 4108'-20' opn 1 hr, rec 20' Mud,
180# Arb. 4166'

TD 4200'

5" @ 4200'

CO 68/ 4088-99 Hydrof~~n~~ac.

S/ 8 to 10 boph 2 hr.

Comp 357 bopd. 2% Wtr.

COMPLETED

County Graham State KansasSec. 12 (Blk.) 10 (Sur.) 23H Map No.Operator Heathman & SeeligsonWell No. 1 Farm ErwinElev. Location SW SW NE

330 Ft. From S Line NE330 Ft. From W Line Quarter1st. Report JAN 1 9 1955

Completion

Remarks Continental - ACCo. toolsSpudding Date 1-15-55Drlg. Data Wildcat8" @ 156 Anhy 1948 drlg. 2345


FABEN GILSTRAT

County Graham State Kansas
 Sec. 12 (Blk. 10 (Sur. 23W Map No.
 (Twp.) (Rge.)

Operator Heathman & Seeligson

Well No. 1 Farm Erwin

Elev. 2409 Location SW SWNE

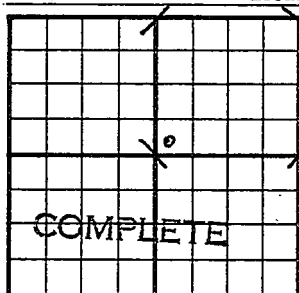

330Ft. From S Line NE

330Ft. From W Line Quarter

1st. Report

Completion MAR 9 1955

Remarks SE Law Pool

Co. tools

Spudding Date 1-15-55

Drlg. Data Oil well TD 4200

8" @ 156 Anhy 1948 Heeb. 3650

Tor. 3670 Lans. 3687 DST 3687-3710

open 1 hr. Rec. 360' vsocw 1260#

DST 3718-27 open 1 hr. Rec. 30' ocm

60' mco 1020# DST 3772-82 open 1 hr.

Rec. 70' msw 1090# DST 3825-38

open 1 hr. Rec. 190' sw 1330#

DST 3846-58 open 2 hr. Rec. 2200' gas

Rec. 510' oil 1045# DST 3861-78

open 45 min. Rec. 15' mud 0#

DST 3881-96 open 1 hr. Rec. 20' mud

75# B KC 3915 Marm. 4001 Cong. 4088

DST 4080-98 open 2 hr. Rec. 850' free

oil 1075# DST 4108-20 open 1 hr.

FABEN GILSTRAP

Drlg. Data

Rec. 20' mud 180# Arb. 4166

TD 4200 5' @ 4200 CO 68/ 4088-99

Hydrefrac S/ 8 to 10 bopd 2 hr.

Comp. 357 bopd 2% wtr.

MAR 15 1955