

Graham


KANSAS

SECTION 12 TOWNSHIP 10 RANGE 23 W

WELL NO. #1 Irwin "A"

COMPANY Continental Oil

NORTH

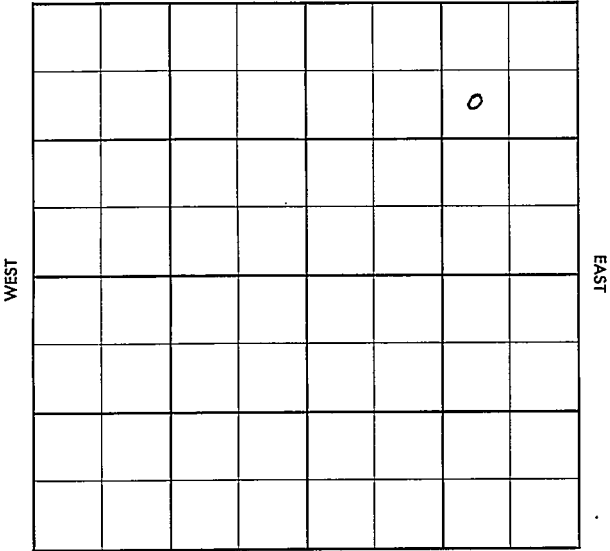

SOUTH

WEST

EAST

SEC.	TWP.	R.
12	10	23W

WELL NO.

#1 Irwin "A"

FARM

COMPANY

Continental Oil

CONTRACTOR

L & J

SE Law


_____ Ft. from N. Line

_____ Ft. from S. Line

_____ Ft. from E. Line

_____ Ft. from W. Line

SW NE NE

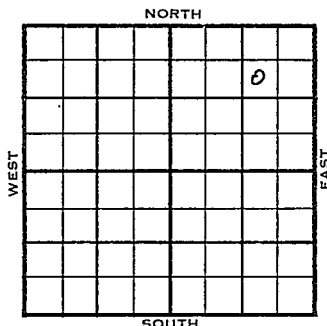

1955

ELEVATION

2410'

REPORT

10-19

Comm 10-13-55
 8" @ 190/150
 Anh 1945
 Drlg 3525

11-16

DST 3682-3700 op 1 hr. rec. 30' mud
 1180/20"

DST 3838-46 op 1 hr. rec. 16' mud
 45/20"

DST 4080-4100 op 2 hrs. rec. 90' hocr
 760/20"

DST 4144-67 op 1 hr. rec. 2730' sw
 1210/20"

5½" @ 4199/200

CO to 4176, 21/4161-68, 500 A,
 CO to 4176, 12/4078-82, 42/ 4086-4100.
 S/ 8½ bo 12 hrs. frac
 S/ 60 bo 7 bw 10 hr., SP 3950
 12/ 3878-82
 B/ 8 go 2 hr., 12/ 3862-68
 B/ 8 go 2 hrs. 21/ 3844-51
 B/ 8 go 2 hrs. SP 3873, 1000 A,
 S/ wtr., sq 3844-54, 3862-68, 3844-51
 CO to 4105 S/ 48 bo 4 bw 8 hrs.
 Comp. 138 bopd 19 Bw.

TopsDepthLog

Tp.

3429

H.

3644

Tr.

3679

11-16	<u>Tops</u>	<u>Depth</u>	<u>Log</u>
	L.	3620	3688
	Marm	4079	
	C.	4977	4990
	A	4176	4161
	TD 4200'		

COMPLETED

County Gram Elev. _____
 Sec. 12 Twp. 10 Rge. 23W
 Company Continental Oil
 Farm Name Irwin "A" No. 1

TOPS	DEPTH	LOG	DATUM
Anh.	<u>1945</u>		
TP.			
H.			
Tr.			
Dg.			
Bl.			
L.			
K.C.			
B.K.C.			
Ce.			
C.			
M.			
M.			
K.			
Mz.			
Me.			
V.			
S.			
S.			
A.			
R.			
PE.			
G.			
T.D.			

Loc. in Sec. SW NE NE
 Geol. _____
 Contr. L & J
 Post SE Law

			0
FIRST REPORT			
OCT 19 1955			

Date Comm. 10-13-55
8" @ 190/150 drlg. 3525

(Handwritten signature)

Co.
Lse.
No.
Sec.
T.
R.

County Graham Elev. 2110
 Sec. 12 Twp. 10 Rge. 23W
 Company Continental
 Farm Name Irwin "A" No. 1

TOPS	DEPTH	LOG	DATUM	Loc. in Sec.
Anh.	1945			
TP.		.3429	1019	SW NE NE
H.		.3644	12314	
Tr.		.3679	1269	
Dg.				
Bl.				
L.	.3620	.3688	1278	Geol.
K.C.				Contr.
B.K.C. <u>Marm</u>	4079		1669	
Ce.				
C.	4077	4090	1680	L & J
M.				Pool
M.				SE Law
K.				
Mz.				
Me.				
V.				
S.				
S.				
A.	4176	4161	1751	
R.				
PE.				
G.				
T.D.	4200			

Date Comm. 10-13-55 NOV 16 1955
 8" @ 190/150 DST 3682-3700 open 1 hr.
 rec. 30' mud 1180/20" DST 3838-46
 open 1 hr. - rec. 16' mud 45/20"
 DST 4080-4100 open 2 hr. rec. 90' hood
 760/20" DST 4144-67 open 1 hr. -
 rec. 2730' sw 1210/20" - 5 $\frac{1}{2}$ " @ 4199/200
 CO to 4176 - 21/ 4161-68 500 A
 CO to 4176 12/ 4078-82 42/ 4086-4100

S/ $8\frac{1}{2}$ bo 12 hr. frac S/ 60 bo 7 bw

10 hr. SP 3950 12/ 3878-82

B/ 8 go 2 hr. 12/ 3862-68 B/ 8 go 2 hr.

21/ 3844-51 B/ 8 go 2 hr. SP 3873

1000 A S/ wtr. -sq 3844-51 3862-68

3844-51 - GO to 4105 S/ .48 bo .4 bw

8 hr. Comp. 138 bopd 19 bw

Scout Cards *P.B.*
Land Small Map
Land Wall Map
Tracings
France Map
Pierce Map
Misc.

NOV 25 1955