


Sheridan KANSAS

SECTION 13 TOWNSHIP 10 RANGE 29W

WELL NO. #1 Johnson

COMPANY Empire Drlg.

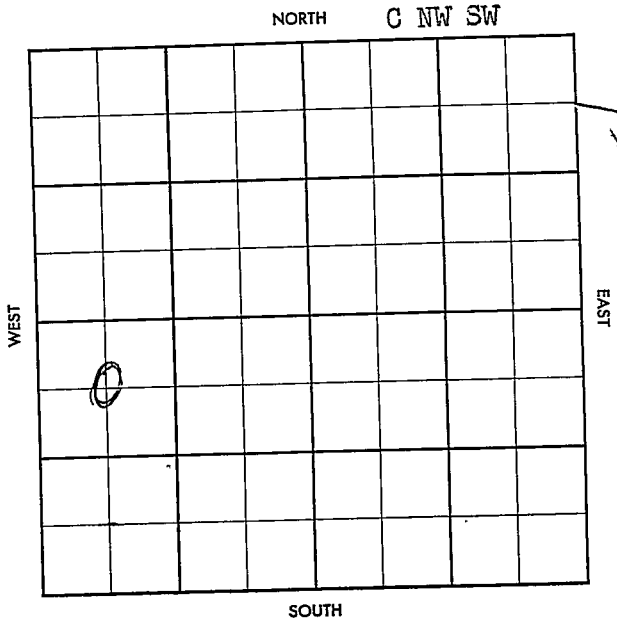

~~WILDCAT~~

County Sheridan Elev. 2812 RB
 Sec. 13 Twp. 70 Rge. 29W
 Company Empire Drlg. No. 1
 Farm Name Johnson

TOPS	DEPTH	LOG	DATUM
Anh.	2110		
Ip.			
H.			
Tr.			
Dg.			
Bl.			
L.			
K.C.			
B.K.C.			
Ce.			
C.			
M.			
M.			
K.			
Mz.			
Mo.			
V.			
S.			
S.			
A.			
R.			
Pe.			
G.			
TR.			

Loc. in Sec. C NW SW

Geol. _____
 Contr. _____
 Co. tools _____
 Pool _____
 Wildcat _____

FIRST REPORT
 JUN 19 1957

Date Comm. 6-12-57 Pan. Am. Center AC
8W @ 210/125 drlg. 3225

~~W~~

Co.

Use.

No.

Sec.

T.

R.

4506
2809
-1697

2809 DE

FORM 513 SUNRAY

County Sheridan Elev. 2,128 RE
 Sec. 13 Twp. 10 Rge. 20W
 Company Imire Dril.
 Farm Name Johnson No. 1

TOPS	DEPTH	LOG	DATUM
Anh.	2110		
TP.			
H.	3913	3907	
Tr.	3930	3934	
Dg.			
Bl.			
L.	3952	3945	
K.C.			
B.K.C.	4206	4202	
Ce.			
C.	Marm 4235		
M	ce 4404	4404	
M.		4506	
K.			
Mz.			
Mo.			
V.			
S.			
S.			
A.			
R.			
PE.			
G.			
TD.	4565		

Loc. in Sec. C NW SW

Geol. _____
 Contr. _____
 Co. tools _____
 Pool _____
 Wildcat _____

ABANDONED

JUL 3 '57

Date Comm. 6-12-57

210/125 11. 3. 5 ✓
 DST 3994 - 4010 1 m. run
 45' 50cm + 60' W/M BHP
 1260/30" DST 4078 - 4105
 30" run 10' Md F# 0 BHP
 230/30" DST 4104 - 25 up
 45" run 10' Md + 1' clear
 oil 0/30" DST 4152 - 81 45"
 run 15' VSOCM BHP 0/30"
 R29 LOG D&A.