


Section 13 Township 10 Range 18 W

Well No. # 1 Gick

Company Murphin & Aledo

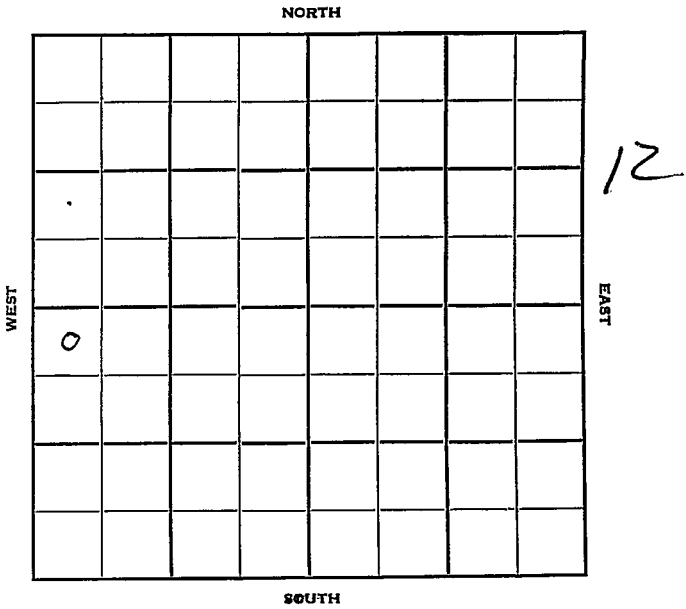

Rooks

KANSAS

18W

Sec. 13

Twp.

10

R.

Well No. #1 Giek

Farm

Murphin & Aledo

Company

Murphin - Contr.

Contractor

Finnesy Pool


330' Ft. from N. Line

Ft. from S. Line

Ft. from E. Line

330' Ft. from W. Line

NW NW SW

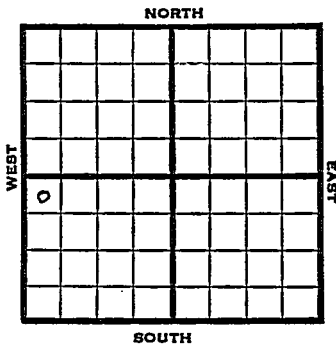

1951

Elev. 2151'

REPORT

7/3

RUR

8/1

Spud 7-5-51 D & A TD 3769'

8" @ 215' Anhy 1472' Heeb 3349'

Lans. 3393'

DST 3544-66 open 90 min. rec 33' SOCM

Cong. 3653' Simp. dol. 3739'

Arb. 3751' TD 3769' D & A

ABANDONED

