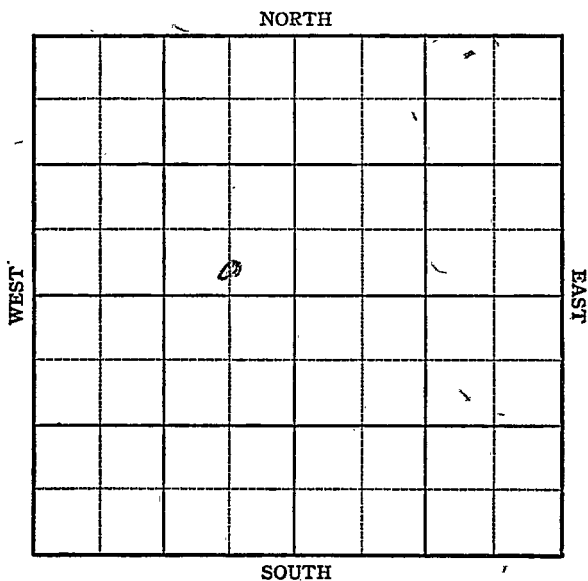


KANSAS

Rooks county

Section 13 Township 10 Range 19-WWell No. #7, VohsCompany Sinclair Prairie Oil Company

KANSAS

Rooks county ✓

Sec. 13 Twp. 10 R. 19-W ✓Well No. #7, Vohs FarmSinclair Prairie Oil Company Company

Vohs Pool

Ft. from N. Line


330'

Ft. from S. Line

660'

Ft. from E. Line

Ft. from W. Line

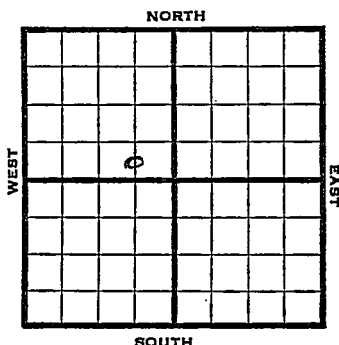

C S L SE NW

1946 Elev. 2127 REPORT

12/11 Location.

12/17 "

1947

1/4 10" @ 1488'
Drlg 2900'

1/8 Drlg 3460'

1/15 Lans 3329'
Cong 3565
Simp 3625'
Arb 3635
Td 3755'
7" @ 3754
RUST1/21 Plug 3400 24 shots
3375-88-1000 Acid
swb 24 W to 8 oil
PH

OVER


1/29 TD 3755'
Lans 3329
Arb 3635
7" @ 3754
Perf Lans
1000 acid
Pump 20 Pot
36 Gravity

COMPLETED

Kansas **KANSAS** Vohs PoolMap No. 65 Sec. 13 Twp. 10 R. 19WWell No. 7 VohsSinclair-Prairie Company**FIRST REPORT**

Contractor

C S L SE NW

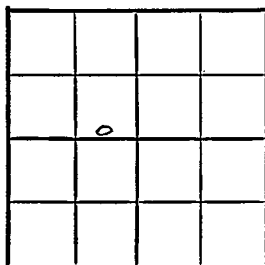SECTION PLAT Ft. from N. Line330 Ft. from S. Line660 Ft. from E. Line Ft. from W. Line

Rooks County

Location XRig up Drilling and Remarks: **RECORD**Cased in., ft.Sand Gas Oil Total Depth **PRODUCTION**1st 24 hrs. Nat. 1st 24 hrs. after shot Gas Cu. Ft.Dry Hole Abandoned

Date

DEC 1 1 1946 19S. J. LEWIS

Scout

