

Section 13 Township 10 Range 19W

Well No. #8 Vohs

Company Sinclair Oil & Gas

Vohs

NORTH

WEST

EAST

0							

SOUTH

Rooks

Sec. 13 Twp. 10 R. 19W

Well No. #8 Vohs Farm _____

Sinclair Oil & Gas Company


Vohs Pool

_____ Ft. from N. Line

330' Ft. from S. Line

_____ Ft. from E. Line

330' Ft. from W. Line

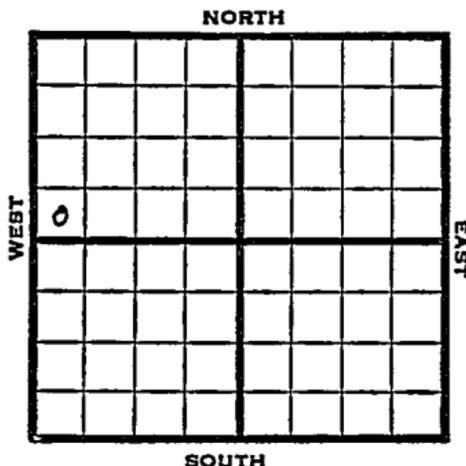

SW NW

1949

Elev 2064' REPORT

12/21 SWD (Location)

12/28 "

1950

2/8 TD 3802'
7" @ 3675'
Salt wtr disposal

- Tops:
Hub 2233'
Dodge 3247'
Lans 3267'
Cong 3503'
Simp 3506'
Arb. 3575'

No shows.
Aband.

ABANDONED

Map No. _____ Sec. 13 Twp. 10 R. 19W

Well No. 8 Vohs

Sinclair Oil & Gas Company

Contractor _____

SW NW

**FIRST REPORT
SECTION PLAT**

_____ Ft. from N. Line

330 Ft. from S. Line

_____ Ft. from E. Line

330 Ft. from W. Line

o			

Rooks County

Location X

Rig up _____

Drilling and Remarks:

SWD

RECORD

Cased _____ in., _____ ft.

Sand _____

Gas _____

Oil _____

Total Depth _____

PRODUCTION

1st 24 hrs. Nat. _____

1st 24 hrs. after shot _____

Gas _____ Cu. Ft.

Dry Hole _____

Abandoned _____

Date

DEC 21 1949 19

S. J. LEWIS

Scout

Kansas

Map No. _____ Sec. 13 Twp. 10 R. 19W

Well No. 8 Vohs SWD

Sinclair Oil & Gas Company

Contractor

SW NW

E: 2064
SECTION FLAT

_____ Ft. from N. Line

330 Ft. from S. Line

_____ Ft. from E. Line

330 Ft. from W. Line



Rooks County

Location _____

Rig up _____

Drilling and Remarks:

7" @ 3675

Salt Water
Disposal

(top over)

RECORD

Cased _____ in., _____ ft.

Sand _____

Gas _____

Oil _____

Total Depth 3802

PRODUCTION

1st 24 hrs. Nat. _____

1st 24 hrs. after shot _____

Gas _____ Cu. Ft.

Dry Hole _____

Abandoned _____

Date

FEB 8 1950 19

J. E. TYRA
Scout

Feb 2233

Dodge 3247


Leas 3267

Coug 3503

Simp 3506

arb 3575

no shows

 

FEB 10 1950

Edith

Scout Cards
Land Small Map
Land Wall Map
Tracings
France Map
Pierce Map
Misc