

KANSAS

Rooks

Section 13 Township 10 Range 20WWell No. 1 SutorCompany Sohio et al

Berland

NORTH

WEST

EAST

							Q

SOUTH

KANSAS

Rooks

10

R.

20W

Sec. 13 Twp. R.

Well No. #1 Sutor Farm

Sohio et al Company

Berland Pool

Ft. from N. Line

330'

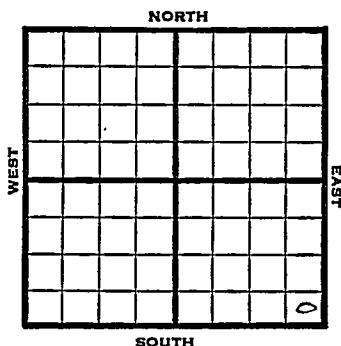
Ft. from S. Line

330'

Ft. from E. Line

Ft. from W. Line

SE/C



1949

Elev 2213'

REPORT

5/11

RUR

5/18

"

5/25

"

6/1

Lans 3446'

Arb. 3755-59'

TD 3759'

5" @ 3757'

6/7

"

6/15

"

6/21

TD 3761'

1600' oil 2 hrs.

6/28

"

7/6

"

7/12

"

7/20

"

7/27

"

8/3

TD 3761'

Arb. 3755'

5" @ 3757'

Pump 190 Oil Pot

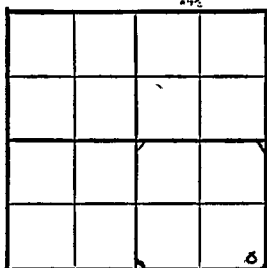
28° Gr.

Comp

COMPLETED

Map No. _____ Sec. 13 Twp. 10 R. 20WWell No. 1 Sutor_____Sohio etal._____
Company_____Rine Drlg._____
Contractor

SE/C

FIRST REPORT
SECTION PLAT_____Ft. from N. Line330 Ft. from S. Line330 Ft. from E. Line_____Ft. from W. LineRooks County

Location _____

Rig up _____

Drilling and Remarks:

R U R

RECORD

Cased _____ in., _____ ft.

Sand _____

Gas _____

Oil _____

Total Depth _____

PRODUCTION

1st 24 hrs. Nat. _____

1st 24 hrs. after shot _____

Gas _____ Cu. Ft.

Dry Hole _____

Abandoned _____

Date

MAY 11 1949

19

S. J. LEWIS

Scout

Kansas

Berland Pool

Map No. K63 Sec. 13 Twp. 10 R. 20WWell No. 1 Sutor

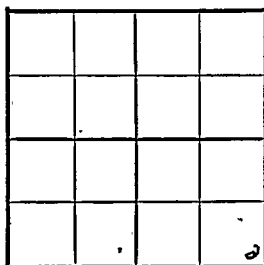
Sonio et al.

Company

COMPLETE

Contractor

SE/C

E1,223
SECTION PLAT Ft. from N. Line330 Ft. from S. Line330 Ft. from E. Line Ft. from W. Line

Rooks County

Location Rig up

Drilling and Remarks:

CR 887555' (88755)Pump 190 oil Prod28 3/4

RECORD

Cased in., ft.Sand Gas Oil Total Depth 29761

PRODUCTION

1st 24 hrs. Nat. 1st 24 hrs. after shot Gas Cu. Ft.Dry Hole Abandoned

Date

AUG 3 1949 19S. J. LEWIS Scout