

Section 13 Township 10 Range 20W

Well No. 2 Sutor

Company Champlin Ref.

Berland
NORTH

WEST

EAST

SOUTH

A 10x10 grid with a small circle in the top-right cell.

KANSAS

Rooks ✓

Sec. 13 Twp. 10 R. 20Well No. 2 Sutor Farm

Champlin Ref. Company

Berland Pool

Champlin Ref. NORTH


990 Ft. from N. Line

Ft. from S. Line

330 Ft. from E. Line

Ft. from W. Line

SE NE NE

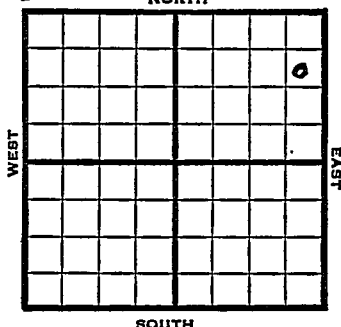

1949 Elev 2227' REPORT

9/28 RUR
10/5 8" @ 258'
Drlg 2547'
10/12 Lansing 3459'
Drlg 3575'
10/19 Arb. 3765'
TD 3780'
5" @ 3780'
10/26 24 shots 3767-71
Swb 40 bbls oil PH
11/1 "
11/9 "
11/23 TD 3780'
Arb. 3765'
5" @ 3780'
Perf
Echo Pot 3000 Oil
27° Gr.
Comp

COMPLETED

Map No. _____ Sec. 13 Twp. 10 R. 20W

Well No. 2 Sutor

Champlin Ref. _____ Company

Champlin Ref. _____ Contractor

SE NE NE


FIRST REPORT
SECTION PLAT

990 Ft. from N. Line

_____ Ft. from S. Line

330 Ft. from E. Line

_____ Ft. from W. Line

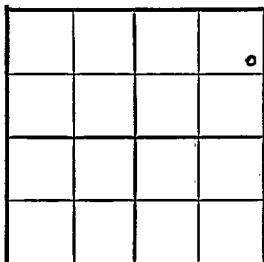

Rooks County

Location _____

Rig up _____

Drilling and Remarks:

R U R

RECORD

Cased _____ in., _____ ft.

Sand _____

Gas _____

Oil _____

Total Depth _____

PRODUCTION

1st 24 hrs. Nat. _____

1st 24 hrs. after shot _____

Gas _____ Cu. Ft.

Dry Hole _____

Abandoned _____

Date

SEP 28 1949

19

S. J. LEWIS

Scout

Kansas

Map No. _____ Sec. 13 Twp. 10 R. 20WWell No. 2 Sutor


Champlin Ref.

Company

COMPLETE

Contractor

SE NE NE

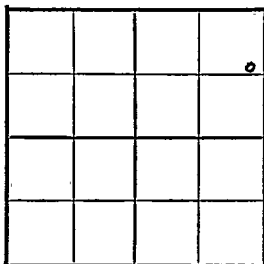E1,2227
SECTION PLAT990 Ft. from N. Line Ft. from S. Line330 Ft. from E. Line Ft. from W. Line

Rooks County

Location _____

Rig up _____

Drilling and Remarks:

*Cerx 3765**5" @ 3780**Perf.**Ech 20 x 3000 oil**27 1/2 hr*

RECORD

Cased _____ in., _____ ft.

Sand _____

Gas _____

Oil _____

Total Depth 3780

PRODUCTION

1st 24 hrs. Nat. _____

1st 24 hrs. after shot _____

Gas _____ Cu. Ft.

Dry Hole _____

Abandoned _____

Date

NOV 23 1949

19

S. J. LEWIS

Scout