

Section 13 Township 10 Range 20W

Well No. #6 Sutor

Company Sohio & Fine Drlg.

Berland Pool NORTH

WEST

EAST

SOUTH

0

Sec. 13 Twp. 10 R. 20W **KANSAS** ✓

Well No. #6 Sutor Farm

Sohio & Rine Drlg.


Berland Pool (Rine Drlg., Contr.) Company

990' Ft. from N. Line

 Ft. from S. Line

 Ft. from E. Line

990' Ft. from W. Line

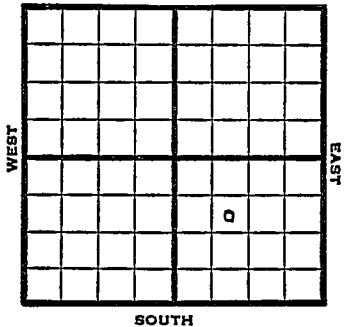

SE NW SE

1949 . Elev 2207' REPORT

12/21 Anhy 1617'
8" @ 1624'

12/28 Drlg 2675'

1950
2/1 TD 3756'
8"@ 1624'
5"@ 3753'
P 122 BOPD
Anhy 1617'
Heeb 3414'
Lans 3449'
Cong 3686'
Arb. 3752'
Comp

COMPLETED

Map No. _____ Sec. 13 Twp. 10 R. 20W

Well No. 6 Sutor

Sohio & Rine Drlg. Company

Rine Drlg. Contractor

SE NW SE


**FIRST REPORT
SECTION PLAT**

990 Ft. from N. Line

 Ft. from S. Line

 Ft. from E. Line

990 Ft. from W. Line

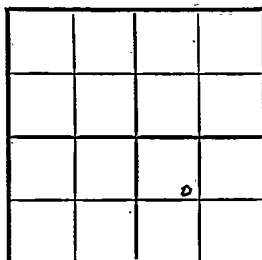

Rooks County

Location _____

Rig' up _____

Drilling and Remarks:

Anhy 1617

8" @ 1624

RECORD

Cased _____ in., _____ ft.

Sand _____

Gas _____

Oil _____

Total Depth _____

PRODUCTION

1st 24 hrs. Nat. _____

1st 24 hrs. after shot _____

Gas _____ Cu. Ft.

Dry Hole _____

Abandoned _____

Date

DEC 21 1949

19

S. J. LEWIS

Scout

Kansas

Map No. _____ Sec. 13 Twp. 10 R. 20WWell No. 6 Sutor_____
Sohio & Rine Drlg. _____ Company_____
Contractor

SE NW SE

E/ 2207

SECTION PLAT

990 Ft. from N. Line

_____ Ft. from S. Line

_____ Ft. from E. Line

990 Ft. from W. Line

			COMPLETE
		o	

Rooks County

Location _____

Rig up _____

Drilling and Remarks:

8" @ 1624'
5" @ 3753
P 122 BOPD
¢

RECORD

Cased _____ in., _____ ft.

Sand _____

Gas _____

Oil _____

Total Depth 3756

PRODUCTION

1st 24 hrs. Nat. _____

1st 24 hrs. after shot _____

Gas _____ Cu. Ft.

Dry Hole _____

Abandoned _____

Date

J. E. TYRA

FEB 1 1950

19

Scout


Arch 1617

Herb 3414

Leaves 3449

Cong 3686

Arch 3752

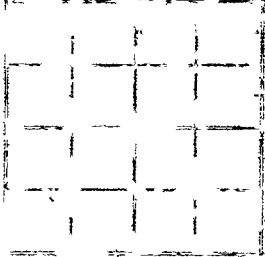

1/4 from N Line
1/4 from E Line
1/4 from S Line
1/4 from W Line

RECORD


















FEB 7 1950

Scout Cards *C. Smith*
Land Small Map *GP*
Land Wall Map
Tracings
France Map
Pierce Map
Misc.