


Section 13 Township 10 Range 20W

Well No. 3 Sutor

Company Glenn Nye

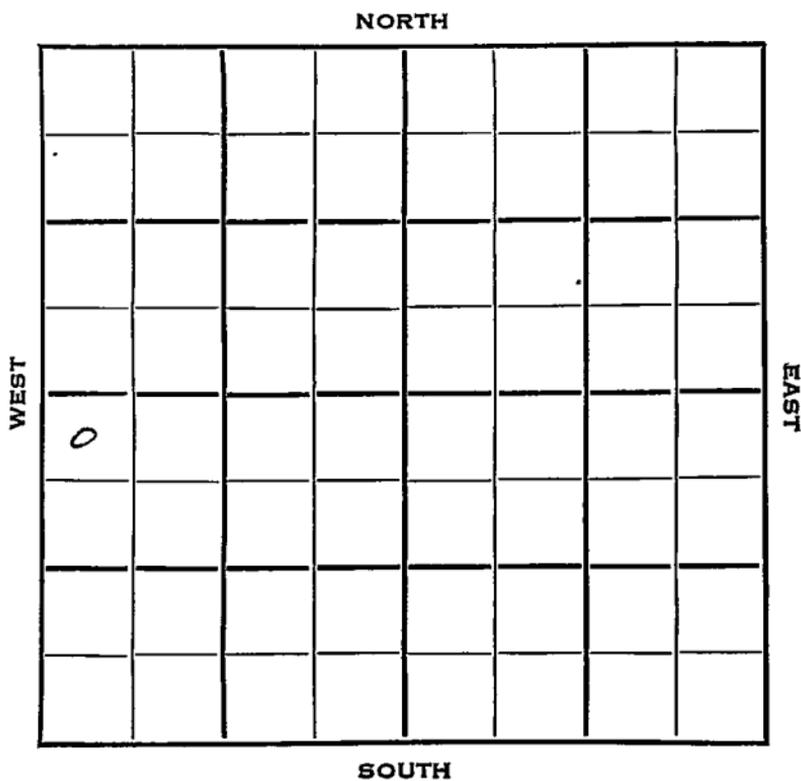

Rooks

Sec. 13 Twp. 10 R. 20W

Well No. #3 Sutor Farm

Glenn Nye Company

Glenn Nye Contr. Contractor


330' Ft. from N. Line

Ft. from S. Line

Ft. from E. Line

330' Ft. from W. Line

NW NW SW

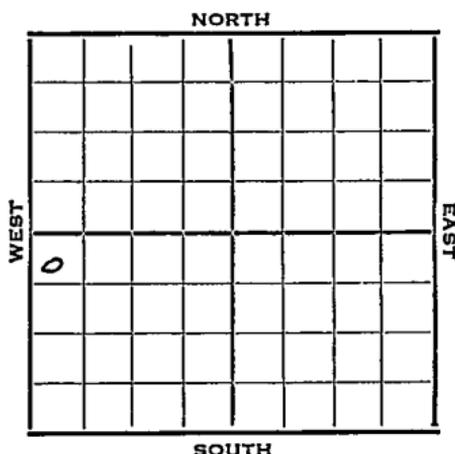

1953

Elev. 2173' REPORT

1/7 Drlg. 3250

1/15 RTD 3802
D&A, HOLD

1/23 D&A
TD 3802
Heeb 3410, tor 3429, Lans 3448,
Marm, 3668, Cong 3702
TD 3802
D&A

ABANDONED

