


Section 13 Township 10 Range 20W

Well No. #8 Suttor "A"

Company Sohie et al

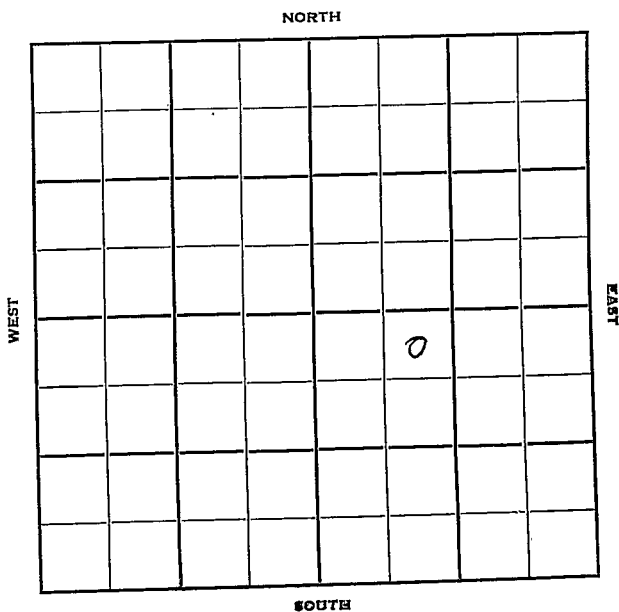

Sec. 13 Twp. 10 R. 20W ✓

Well No. #8 Suttor "A" Farm

Sohio et al Company

Rine Drlg. & Contr. Contractor
Berland Pool


330' Ft. from N. Line

_____ Ft. from S. Line

_____ Ft. from E. Line

990' Ft. from W. Line

NE NW SE

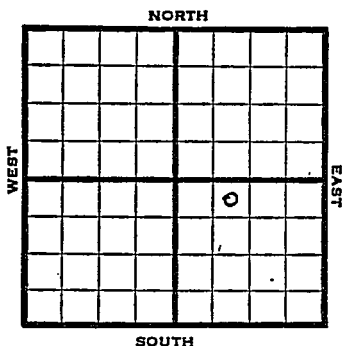

1950 Elev. 2207' REPORT

9/8 Spud 9-8-50
Anhy 1625'
Shut down

10/18 Spud 9-8-50
Oil Well TD 3753'
Anhy 1625'
8-5/8" @ 1640'
Heeb 3411' Lans. 3447'
DST 3604-32 opn 20 mins
Rec. 95' HOCM
Arb. 3748-51
5" @ 3749'
TD 3752'
2 BOPH for 3 hr. DD 3753
500 A Comp. Echo pot. 1866 BOPD
10% wtr.

COMPLETED

County Rooks State Kansas

Sec. 13 (Blk. Twp.) 10 (Sur. Rge.) 20W Map No.

Operator Sohio etal.

Well No. 8 Farm Sutton "A"

Elev. _____ Location NE NW SE

330 Ft. From N Line SE

990 Ft. From W Line Quarter

1st. Report SEP 13 1950

Completion _____

Remarks _____

Spudding Date 9-8-50

Drlg. Data Berland Pool

Anhy 1625 Shut down

County _____ Rocks _____ State KansasSec. 13 (Blk.
Twp.) 10 (Sur.
Rge.) 20W Map No. _____Operator Sohio etal.Well No. 8 Farm Suttor "A"Elev. 2207 Location NE NW SE

330 Ft. From N Line SE990 Ft. From W Line Quarter

Ist. Report _____

Completion OCT 18 1950Remarks Berland PoolRine Drlg. - Contr.Spudding Date 9-8-50Drlg. Data Oil well TD 3753Anhy 1625 8 5/8" @ 1640 Heeb. 3411Lens. 3447 DST 3604-32 open 20 min.Rec. 110' free oil DST 3336-60 open 1 hrRec. 95' HOCm Arb. 3748-51 5" @ 3749TD 3752 2 boph for 3 hr. DD 3753500 A Comp. Echo pot. 1866 bopd 10% water