


Section 13 Township 10 Range 20W

Well No. #5 Earl Sutor

Company Champlin Ref.

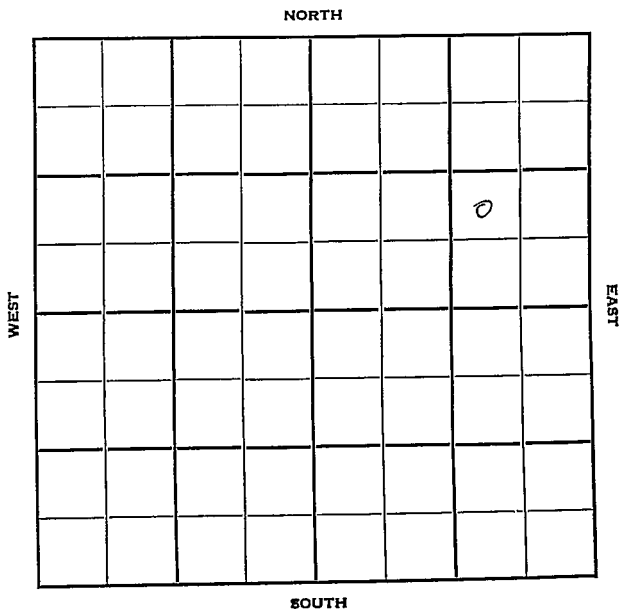

Rooks

Sec. 13 Twp. 10 R. 20W ✓

Well No. #5 Earl Sutor Farm

Champlin Ref. Company

Contractor

Berland Pool


Ft. from N. Line

990' Ft. from S. Line

990' Ft. from E. Line

Ft. from W. Line

NW SE NE

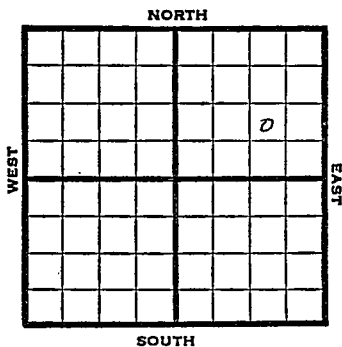

1950

Elev. 2216' REPORT.

3/15

RUR

6/7

8" @ 244'

Heeb 3424'

Lans. 3456'

Congl 3692'

Simp 3772'

Arb 3789'

5" @ 3787'

TD 3842

Test wtr in Arbuckle

Set plug @ 3699'

Perf 24/359-96

" 12/3536-42

Test 2 bbls salt wtr  
pr hr

Plug back to 3520

Perf 30/3490-3500

30/3485-90

P 61 BOPD 5% wtr.

**COMPLETED**

Map No. \_\_\_\_\_ Sec. 13 Twp. 10 R. 20W

Well No. 5 Earl Sutor

Champlin Ref. Company

Contractor

NW SE NE

**SECTION PLAT**

\_\_\_\_\_ Ft. from N. Line

990 Ft. from S. Line

990 Ft. from E. Line

\_\_\_\_\_ Ft. from W. Line


**FIRST REPORT**

Rooks County

Location \_\_\_\_\_

Rig up \_\_\_\_\_

Drilling and Remarks:

R U R

**RECORD**

Cased \_\_\_\_\_ in., \_\_\_\_\_ ft.

Sand \_\_\_\_\_

Gas \_\_\_\_\_

Oil \_\_\_\_\_

Total Depth \_\_\_\_\_

**PRODUCTION**

1st 24 hrs. Nat. \_\_\_\_\_

1st 24 hrs. after shot \_\_\_\_\_

Gas \_\_\_\_\_ Cu. Ft.

Dry Hole \_\_\_\_\_

Abandoned \_\_\_\_\_

Date

MAR 15 1950

19

J. E. TYRA

Scout

Kansas

Map No. \_\_\_\_\_ Sec. 13 Twp. 10 R. 20WWell No. 5 Earl Sutor

Champlin Ref.

Company \_\_\_\_\_

Contractor \_\_\_\_\_

NW SE NE

E1. 2216  
SECTION PLAT

\_\_\_\_\_ Ft. from N. Line

990 Ft. from S. Line990 Ft. from E. Line

\_\_\_\_\_ Ft. from W. Line

COMPLETE			
			o

Rocks \_\_\_\_\_

Location \_\_\_\_\_

Rig up \_\_\_\_\_

Drilling and Remarks:

8" @ 244  
 Kub 3424  
 Lens 3456  
 Cong 3692  
 Simp 3772  
 and 3789

Date

5" @ 3787

## RECORD

Cased \_\_\_\_\_ in., \_\_\_\_\_ ft.

Sand \_\_\_\_\_

Gas \_\_\_\_\_

Oil \_\_\_\_\_

Total Depth 3842

## PRODUCTION

1st 24 hrs. Nat. \_\_\_\_\_

1st 24 hrs. after shot \_\_\_\_\_

Gas \_\_\_\_\_ Cu. Ft.

Dry Hole \_\_\_\_\_

Abandoned \_\_\_\_\_

(over)

JUN 7 1950 19

J. E. TYRA Scout

test water in Arluuckh.

set plug @ 3699

perf 24/359-96

perf 12/3536-42

test 2. Bble Saltwater per Hr.

Plug back to 3520

perf 30/3490-3500

30/3485-90

P 61 BOPD  
570 water

*[Handwritten signature]*

- Scout Cards
- Land-Small Map
- Land-Wall Map
- Tracings
- France Map
- Pierre Map
- Misc.

JUN 15 1950