

Section 13 Township 10 Range 20WWell No. #6 Earl SutterCompany Champlin Ref.

NORTH

						0	

WEST

EAST

SOUTH

Sec. 13 Twp. 10 R. 20W ✓

Well No. #6 Earl Sutter Farm

Champlin Ref. Company


Berland Pool Contractor

330' Ft. from N. Line

 Ft. from S. Line

 Ft. from E. Line

990' Ft. from W. Line

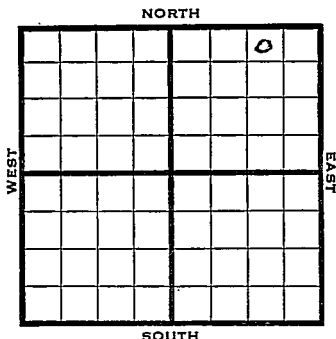

NW NE NE

1950

Elev 2204

REPORT

3/29 Spud 3-26-50
8" @ 245'
WOC

5/17 TD 3744
8" @ 245
Lans 3442
Cong 3681
Simp 3717
Abr 3738
5" @ 3739
243 BOPD
Completed

COMPLETED

Kansas

Berland Pool

Map No. _____ Sec. 13 Twp. 10 R. 20W

Well No. 6 Earl Suttor

Champlin Ref. _____ Company

Contractor

NW NE NE

SECTION PLAT

330 _____ Ft. from N. Line

_____ Ft. from S. Line

990 _____ Ft. from E. Line

_____ Ft. from W. Line

			0

FIRST REPORT

Rooks County

Location _____

Rig up _____

Drilling and Remarks:

Spud 3-26-50

8" @ 245 WOC

RECORD

Cased _____ in., _____ ft.

Sand _____

Gas _____

Oil _____

Total Depth _____

PRODUCTION

1st 24 hrs. Nat. _____

1st 24 hrs. after shot _____

Gas _____ Cu. Ft.

Dry Hole _____

Abandoned _____

Date

MAR 29 1950

19

J. E. TYRA

Scout

Map No. _____ Sec. 13 Twp. 10 R. 20WWell No. 6 Earl Suttor

Champlin Ref.

Company

Contractor

NW NE NE

El. 2204


SECTION PLAT

330 Ft. from N. Line

_____ Ft. from S. Line

990 Ft. from E. Line

_____ Ft. from W. Line

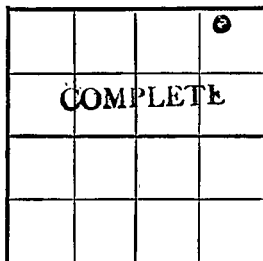

Rocks

Location _____

Rig up _____

Drilling and Remarks:

8" @ 243
Lans 3442cong 3681Silur 3717carb 37385" @ 3739

RECORD

Cased _____ in., _____ ft.

Sand _____

Gas _____

Oil _____

Total Depth 3744

PRODUCTION

1st 24 hrs. Nat. _____

1st 24 hrs. after shot _____

Gas _____ Cu. Ft.

Dry Hole _____

Abandoned _____

Date

243 BOPD

MAY 17 1950

19

J. E. TYRA

Scout