


Section 13 Township 10 Range 20W

Well No. #11 Earl Sutor

Company Champlin

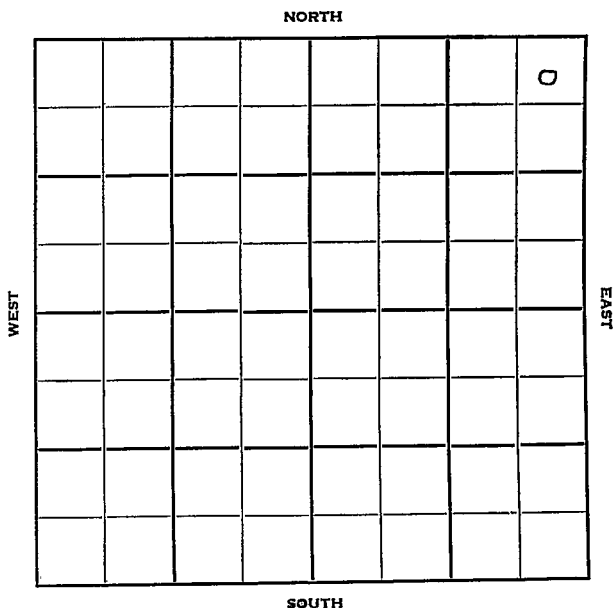

Sec. 13 Twp. 10 R. 20WWell No. #11 Earl Sutor FarmChamplin Company

Contractor


330' Ft. from N. Line

Ft. from S. Line

330' Ft. from E. Line

Ft. from W. Line

NE NENE

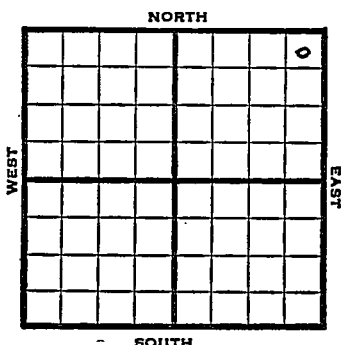

1952 Elev. 2218' REPORT

5/21 Spud 5-19-52

5/28 8" @ 169' Heeb 3416' Tor 3438'
Lans. 3453'

DST 3478-3505, 1 hr, 25' M 200#

DST 3535-55', 1/2 hr, 445' clean oil,
20' OCM, 1050#6/11 RTD 3759 5" @ 3757 CO 3759
S/30 BFPH 50% oil POP

6/18 NR

6/25 Spud 5-19-52

Oil Well TD 3759 8" @ 169

Heeb. 3416 Tor. 3438

Lans. 3453

DST 3478-3505 open 1 hr. rec. 25' mud

DST 3535-55 open 1/2 hr. rec. 445'

clean oil 20' ocm

DST 3576-3600 open 1/2 hr. rec. 24' ocm
426' oil

Cong. 3715 Arb. 3756

TD 3759 5" @ 3757 CO to 3759

S/ 30 bfph

Comp. 139 bopd 43% wtr.

COMPLETED

County Rooks State KansasSec. 13 (Blk. Twp.) 10 (Sur. Rge.) 20W Map No.Operator ChamplinWell No. 11 Farm Earl SutorElev. 2218 Location NE NE NE

							0

330 Ft. From N Line NE330 Ft. From E Line Quarter1st. Report MAY 21 1952

Completion

Remarks

Spudding Date 5-19-52

Drig. Data

J. G. McGEHEE

County Rooks State Kansas
 Sec. 13 (Blk. 10) (Sur. 20W) Map No.
 Operator Champlin Ref.
 Well No. 11 Farm Earl Sutor
 Elev. 2218 Location NE NE NE

							0

330 Ft. From N Line NE

330 Ft. From E Line Quarter

1st. Report

Completion JUN 25 1952

Remarks

Spudding Date 5-19-52Drig. Data Oil well TD 3759

8" @ 169 Heeb. 3416 Tor. 3438

Lans. 3453 DST 3478-3505 open 1 hr.

Rec. 25' mud DST 3535-55 open $\frac{1}{2}$ hr.

Rec. 445' clean oil 20' ocm DST 3576-

3600 open $\frac{1}{2}$ hr. Rec. 24' ocm 426' oil

Cong. 3715 Arb. 3756 TD 3759

5" @ 3757 CO to 3759 S/ 30 bfph

Comp. 139 bopd 43% water

J. G. McGEHEE