


Section 13 Township 10 Range 20W

Well No. #5 Sutor "A"

Company Sohio et al

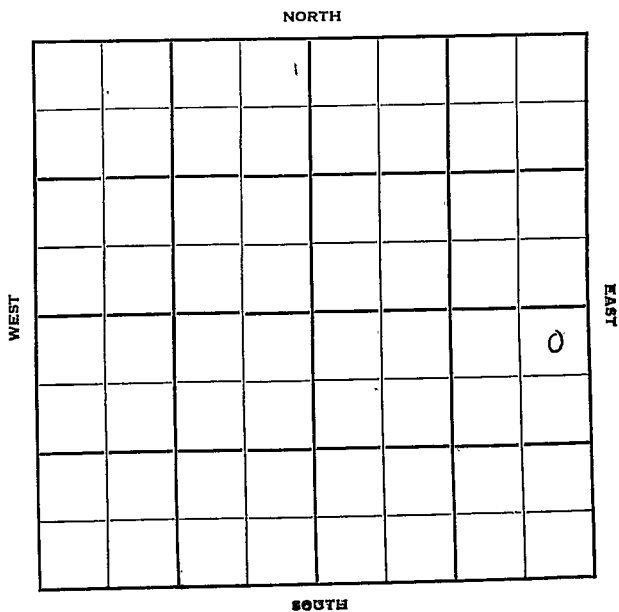

Rooks

KANSAS
20W ✓

Sec. 13 Twp. 10 R. 20W

Well No. #5 Sutor "A" Farm

Sohio et al Company

Rine Drlg. Contractor

300
330' Berland Pool


Ft. from N. Line

Ft. from S. Line

300
330' Ft. from E. Line

Ft. from W. Line

NE NE SE (Twin)

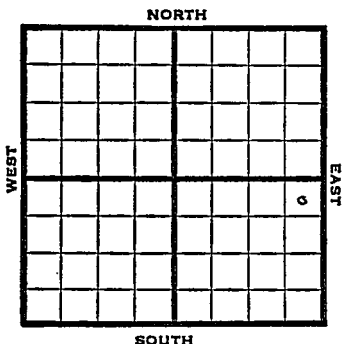

1950 Elev. 2220' REPORT

8/30 Spud 8-24-50
Anhy 1625'
8-5/8" @ 1635'
Drlg. 1642'

11/1 Spud 8-24-50
Oil Well TD 3762'
Anhy 1625'
8-5/8" @ 1635' Lans. 3455'
DST 3510-42 opn 1/2 hr. Rec. 540' SW
DST 3583-3601 opn 1/2 hr Rec. 570'
oil
Arb. 3756-62 5 1/2" @ 3759'
32/3588-96 500 A S/752 BOPD
SP 3549' 27/3492-99
S/1 BO 17 BW 12 hrs. SP 3476
24/3492-98 500 A S/22 BO plus 20% wtr
Comp. 557 BOPD 10% wtr.

COMPLETED.

