

Rooks

62 78
O. W. D. D

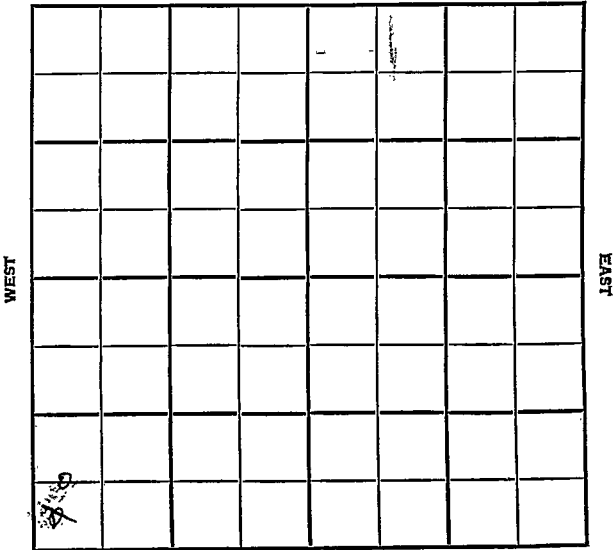
KANSAS

Section 13 Township 10 Range 20W

Well No. #1 Sutor "D"

Company I. O. Miller
~~Farmer~~

NORTH



SOUTH

O. W. D. D

Rooks

KANSAS

SEC.	TWP.	R.
13	10	20 W

WELL NO.

1 Sutor "D"

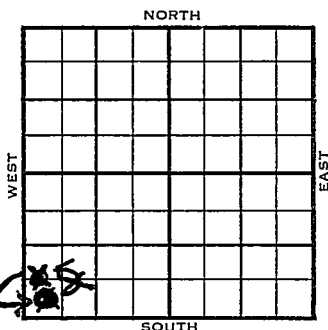
FARM

COMPANY

CONTRACTOR

~~Armer~~ I. O. MillerVIRGINIA
Co. ~~fools~~Berland Pool
Marquette Pool
Ft. from N. Line~~660~~
~~330~~ 330 Ft. from S. Line

Ft. from E. Line

~~250~~
~~330~~ 330 Ft. from W. Line~~SW 1/4 SW SW~~
~~SW SW SW~~
SW SW SW

1954

ELEVATION

2192'

REPORT

9/1

Spud 8-30-54

9/15

Spud 8-30-54

D & A TD 3771 8" @ 203

Anhy 1620 Heeb 3423 Tor 3445

Doug. 3454 KC 3461 Cong. 3701

Arb. 3758

DST 3732-62 open 1 hr rec 10' mud
100#

DST 3761-65 open 1 hr rec 10' SOCM

10' HO CM, 1 pt. free oil 0#

DST 3766-71 open 1 hr rec 60' SOCMW
575# TD 3771 D & A

ABANDONED.

O. W. D. D

1955

11/23

MIR.

OTD 3771' A 3758'

1956

1-5

DD 4242

5 1/2" @ 3900/500

CO to 4242

CompSWD well

A. 3758

R. 4237

TD 4242'

ABANDONED

FABEN GILSTRAP

Kansas

Map No. _____ Sec. 13 Twp. 10 R. 20WWell No. 1 Sutor

Armer _____ Company _____

CORRECTION

Contractor _____

C $W\frac{1}{2}$ SW SW

SECTION PLAT

_____ Ft. from N. Line

660 Ft. from S. Line

_____ Ft. from E. Line

250 Ft. from W. Line

o			

Rooks County

Location _____

Rig up _____

Drilling and Remarks:

Reported
SW SW SW

RECORD

Cased _____ in., _____ ft.

Sand _____

Gas _____

Oil _____

Total Depth _____

PRODUCTION

1st 24 hrs. Nat. _____

1st 24 hrs. after shot _____

Gas _____ Cu. Ft.

Dry Hole _____

Abandoned _____

Date

SEP 8 1951

FABEN GILSTRAP Scout

FABEN GILSTRAP

O. W. D. D

FORM 513 REV. SUNRAY

OWDD for SWD

County Rocks Elev. 2 192
 Sec. 13 Twp. 10 Rge. 20W
 Company I. O. Miller (was Arner)
 FarmName Sutor #D# No. 1

TOPS	DEPTH	LOG	DATUM	Loc. in Sec.
Anb.				SW SW SW
Tr.				
H.				
Dg.				
BL.				
L.				
K.C.				Geol.
B.K.C.				Contr.
Ce.				<u>Virginia</u>
C.				
M.				Pool
M.				<u>Ma rcotte</u>
K.				
Mz.				
Me.				
V.				
S.				
S.				
A.	<u>3758</u>			
R.				
Pe.				
G.				
T.D.	<u>3 771</u>			

NOV 23 '55
FIRST REPORT
0

Date Comm.

M I R

Co.

Lse.

No.

Sec.

T.

R.

CORRECTION

CORRECTION

FORM 513 REV. SUNRAY

County Hooks

Elev. _____

Sec. 13 Twp. 10 N Rge. 20WCompany T. O. MillerFarm Name Sutor "D"No. 1

TOPS

DEPTH

LOG

DATUM

Loc. in Sec. _____

Anh. _____

Tp. _____

H. _____

Tr. _____

Dg. _____

Bl. _____

L. _____

K.C. _____

B.K.C. _____

Ce. _____

C. _____

M. _____

M. _____

K. _____

Mz. _____

Mq. _____

V. _____

S. _____

S. _____

A. _____

R. _____

Pe. _____

G. _____

G. _____

T.D. _____

C W $\frac{1}{2}$ SW SW

Geol. _____

Contr. _____

Pool

Marcolle

CORRECTION

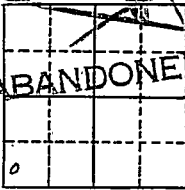
Date Comm. _____

JAN 5 1956

Reported SW SW SWMarcolle Pool

OTD for SWD

County Rooks Elev. 2192Sec. 13 Twp. 10 Rgs. 20WCompany I. O. Miller (was Armer)Farm Name Sutor "D" No. 1

TOPS	DEPTH	LOG	DATUM	Loc. in Sec.
Anh.				<u>W$\frac{1}{2}$ SW SW</u>
Tr.				
Dg.				
BL.				
L.				Geol.
K.C.				Contr.
B.K.C.				<u>Virginia</u>
Ce.				Pool
C.				<u>Marcotte</u>
M.				
M.				
K.				
Mz.				
Me.				
V.				
S.				
S.				
A.	<u>3758</u>		<u>1566</u>	
R.	<u>4237</u>		<u>2145</u>	
Pe.				
G.				
T.D.	<u>4242</u>			

Date Comm. JAN 5 1956OTD 3771 DD 4242 5 $\frac{1}{2}$ " @ 3900/500

CO to 4242 Comp. SWD well